


TAX MAP COPY

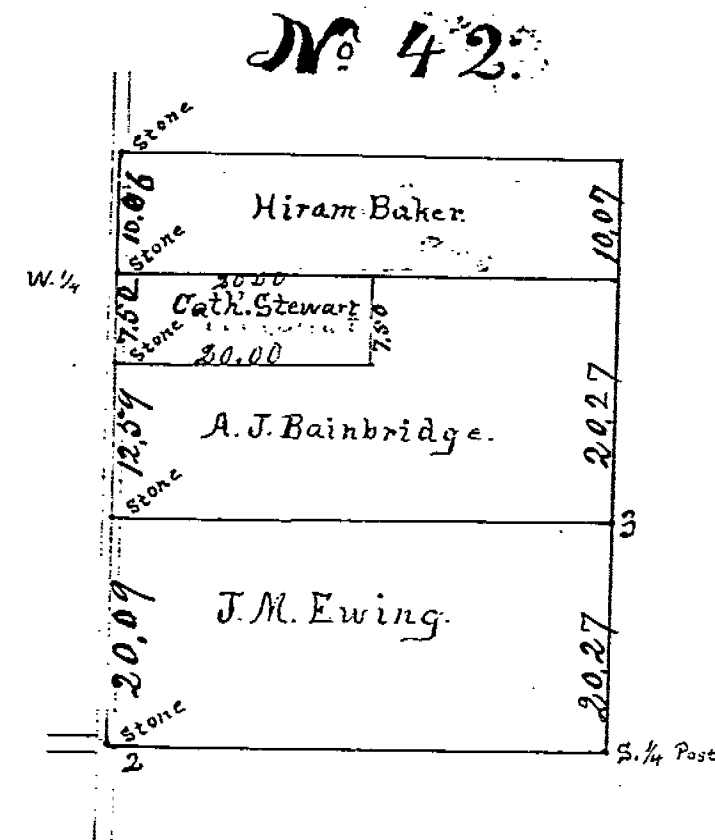

JACKSON TOWNSHIP.

Oct 1st 1891.

Notes at 1 Jack Oak 12. N. 74½ E. 36 links
 .. 2 Hickory 10. N. 20 E. 80 ..
 " 3 B. Oak 8 N 66 9 & 10 S 13 E 19.

Survey of S.W. ¼ & S½ S½ N.W. ¼

Sec. 26 T3S. R12E

For: J.M. Ewing : A.J. Bainbridge : Cath Stewart
 and Hiram Baker.

TAX MAP COPY

No 43.

Jackson Township

July 19th 1891


Survey of Lot No 23 of the
Original town of Kirby Ohio

Dotted Red line represents the Original
Street as laid out - The new street -


Diverges 21 feet 5 inches from
old plat at north line of
lot No. 23 - The

Pivotal point is in center of
P.F.W and C R.R. Track -

Surveyed for M. Inman

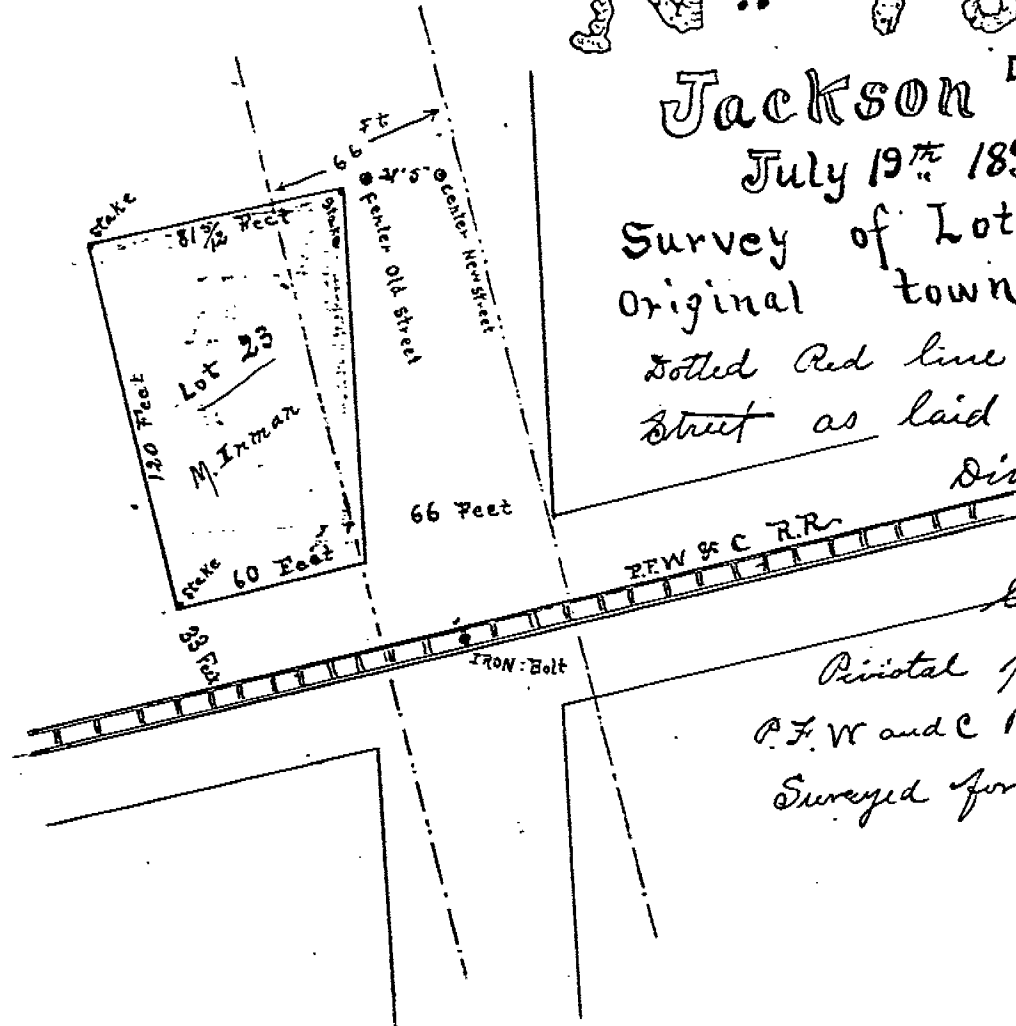

TAX MAP COPY

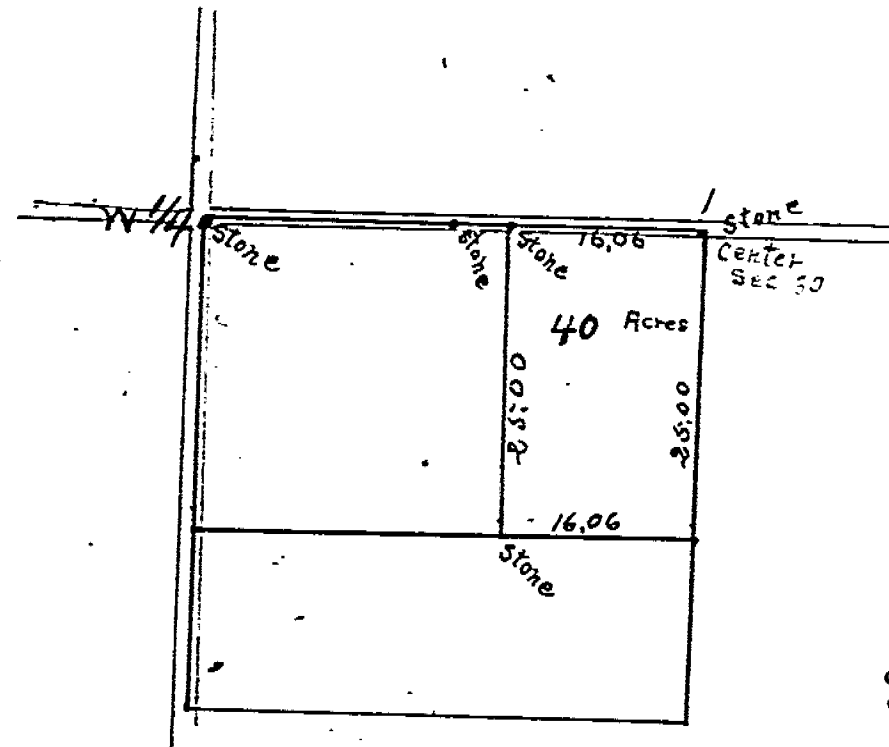

No. 44.

EDEN Township

Sept. = 8th 1897

Survey of 40 Acres off of the East
Side npt SW 1/4 Sec 30 T2 SR 15 E
For Mrs Poole

at 1 Aspen 10 N 55 1/4 W 82

Same tract as in P.B. Beidler Survey: 1864