
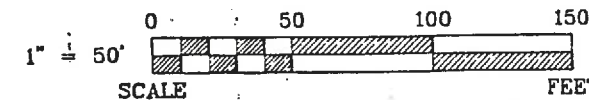


JAMES SCHILLING, et ux

H.A.N.K. & ASSOCIATES, INC.

ENGINEERING • SURVEYING • PLANNING
49 SOUTH WASHINGTON STREET, CLEVELAND, OHIO 44115
(419) 448-0908 447-8369 294-2028 531-8345

SURVEY FOR: JAMES SCHILLING
LOCATED IN THE SE. 1/4 OF SECTION 24,
EDEN TOWNSHIP, T-2-S, R-14-E,
WYANDOT COUNTY, OHIO

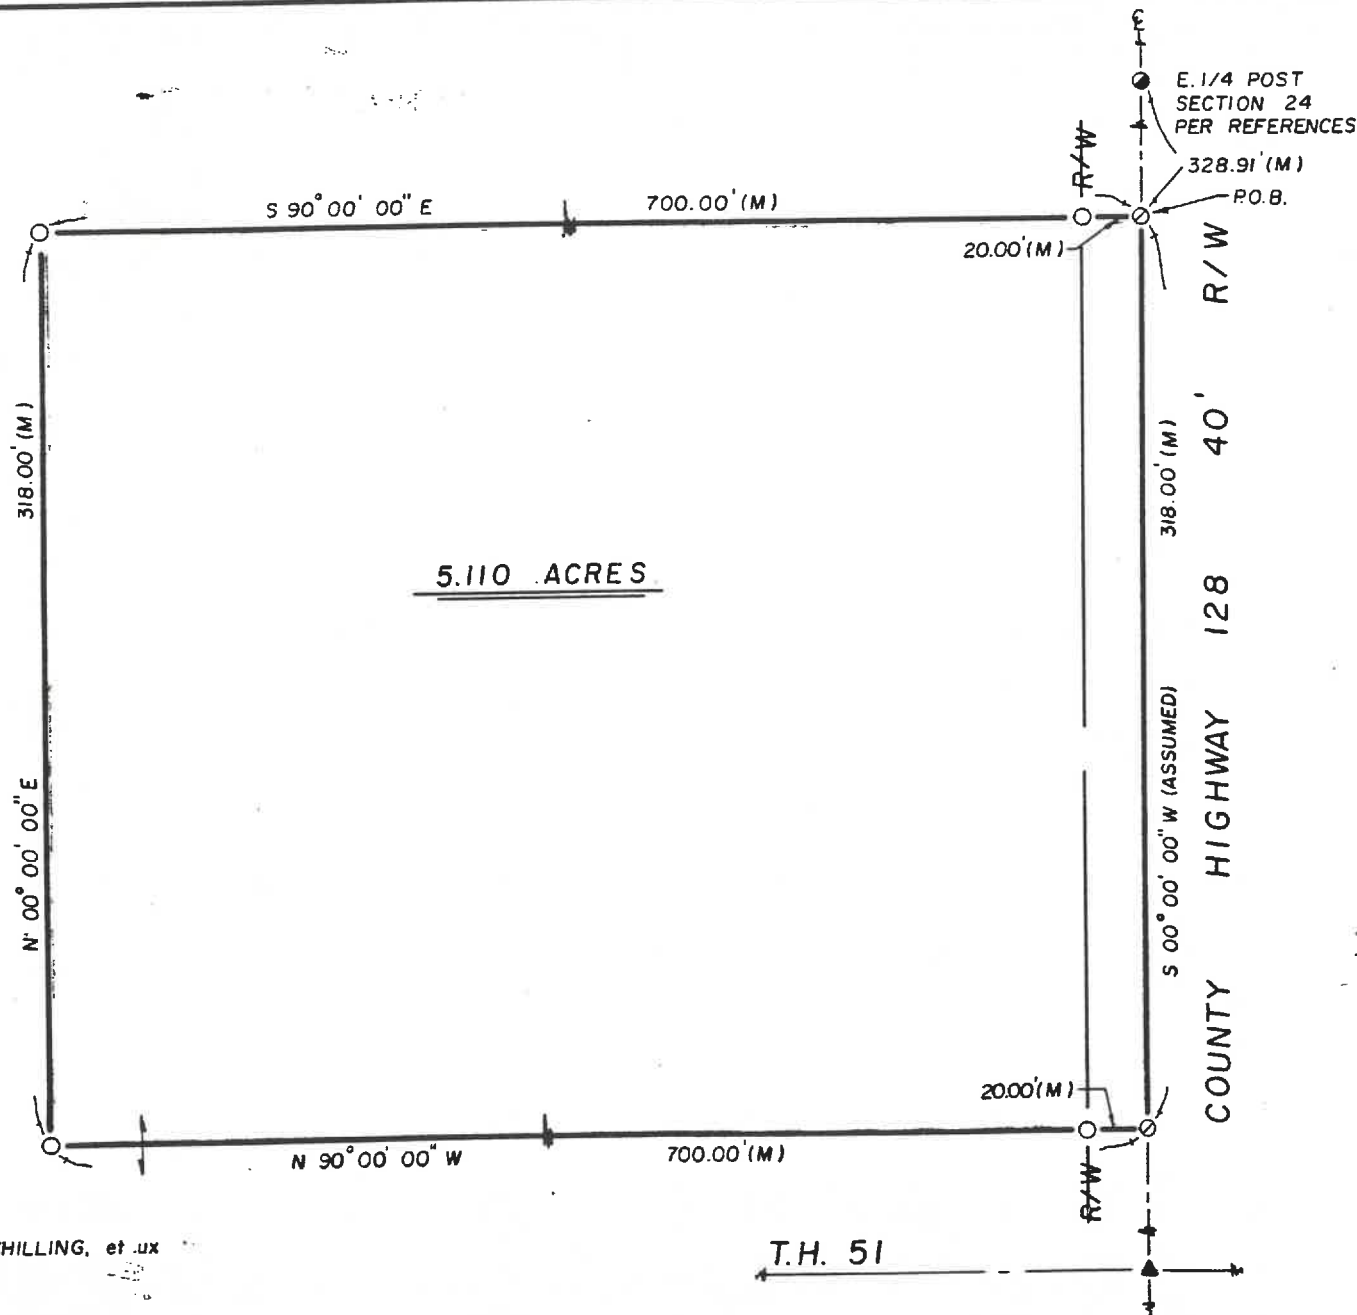

REFERENCES

DEED VOLUME 8 PAGE AS SHOWN
WYANDOT COUNTY CORNERSTONE REFERENCES

SURVEY NO. 3549

RECORDED MAY 10 1989

SURVEY RECORD VOL 6 PAGE 511

TAX MAP DEPT. WYANDOT CO.

LEGEND

SET	FOUND	DESCRIPTION
▲	■	STONE
⊠	⊠	MONUMENT BOX
⊙	⊙	CONC. MONUMENT
⊕	⊕	RAILROAD SPIKE
⊖	⊖	NAIL
⊗	⊗	IRON ROD
⊘	⊘	IRON PIPE
⊙	⊙	DRILL HOLE
⊕	⊕	WOOD POST
⊖	⊖	DEED
⊗	⊗	PLAT
⊘	⊘	MEASURED
⊙	⊙	SURVEYED
⊕	⊕	CALCULATED

I HEREBY DECLARE THAT THE ABOVE PARCEL WAS
SURVEYED DURING MAY, 1989.
PROPERTY LINES SHOWN ARE LOCATED FROM DEEDS
ON RECORD AND ARE BEING LOCATED FROM DEEDS
ASSIGNED FOR ANNUAL REASSESSMENT ONLY. ALL
INFORMATION SHOWN IS TRUE AND CORRECT TO THE
BEST OF MY KNOWLEDGE AND BELIEF.



James G. Homan Jr.
JAMES G. HOMAN, JR., P.E. NO. 8072
Original signed in red ink

DRAWN BY	CHECKED BY	SHEET NO.
DJN	JGH	1/1
REVISIONS		JOB NO.
		89023-S