


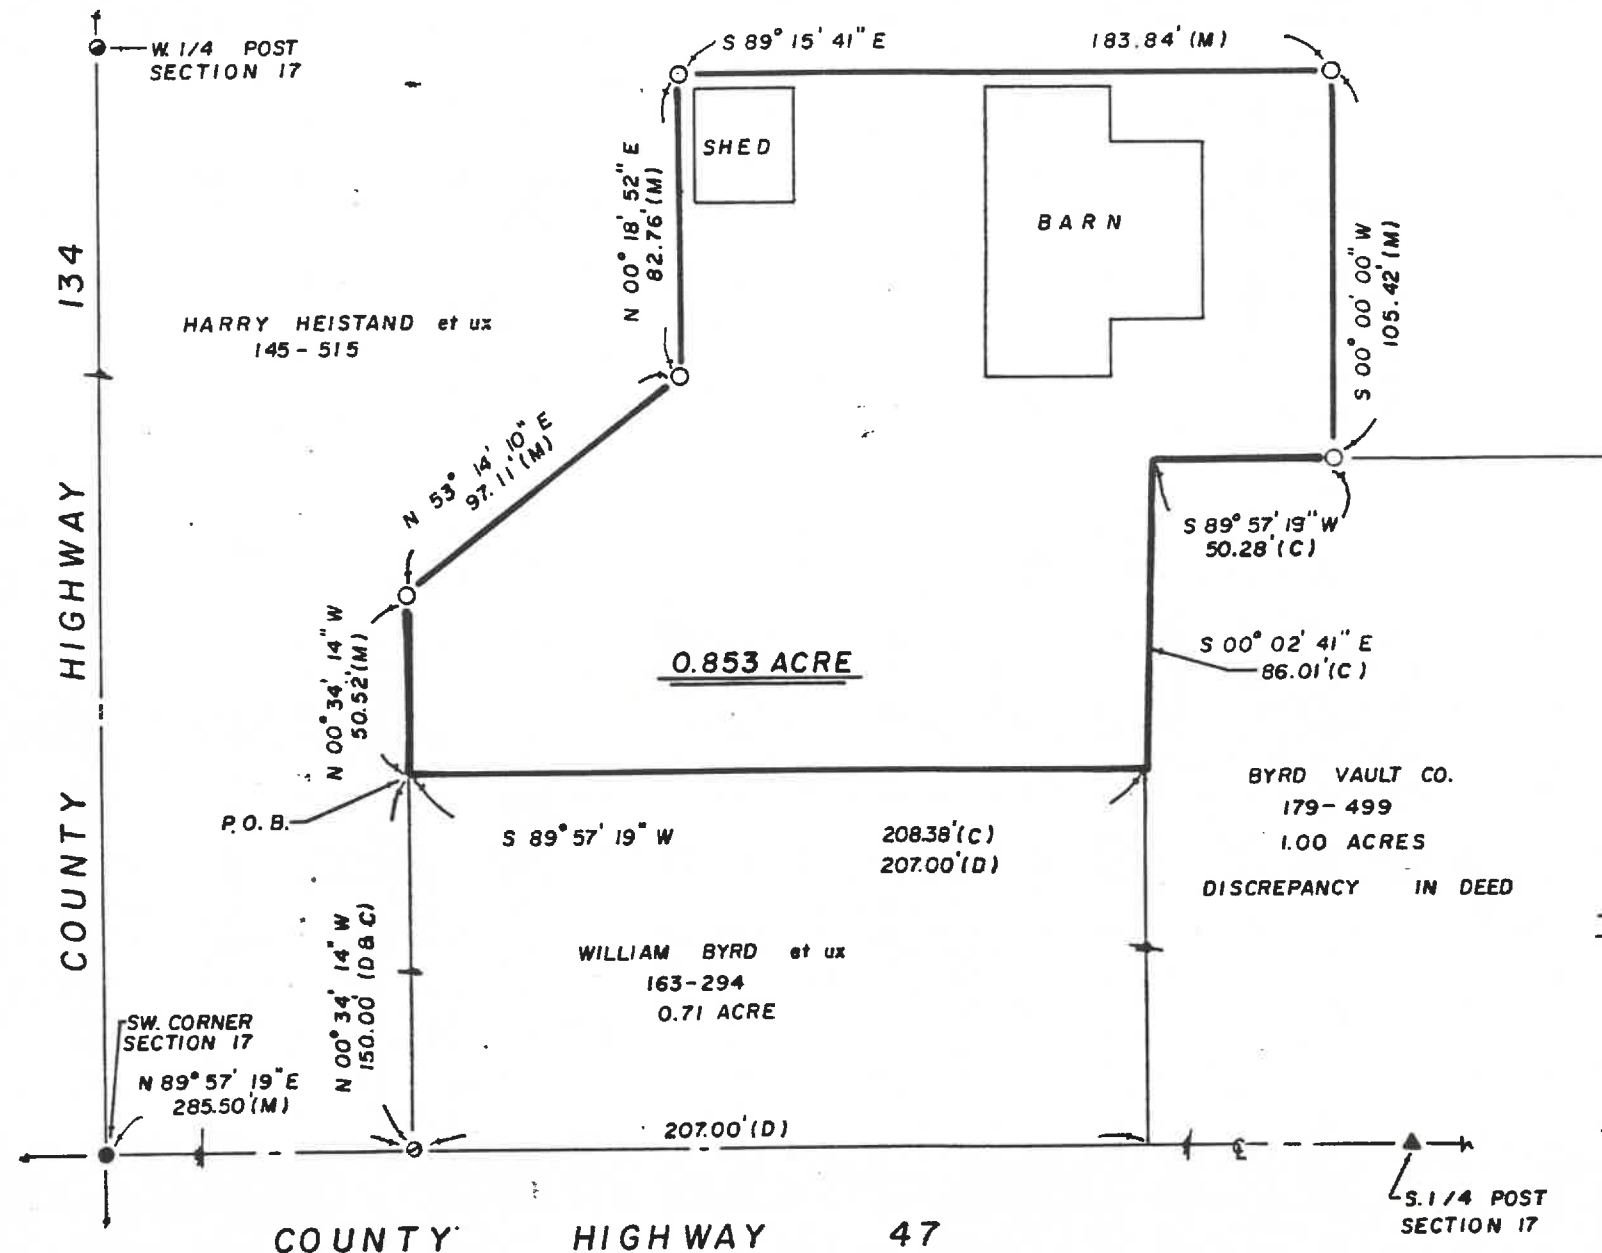

1"=40'
scale feet

REFERENCES

DEED VOLUME B PAGE AS SHOWN
WYANDOT COUNTY CORNERSTONE REFERENCES

SURVEY NO. 3583 ✓

RECORDED JUNE 6 1989

IN SURVEY RECORD VOL 6 PAGE 524

TAX MAP DEPT. WYANDOT CO.

NOTE: ALL IRON PIPE SET ARE 3/4" DIA. WITH
PERSONALIZED CAPS. (J.G.H. #6972)

LEGEND

SET	FOUND	DESCRIPTION
△	▲	STONE
⊠	⊠	MONUMENT BOX
⊙	⊙	CIRC. MONUMENT
⊕	⊕	RAILROAD SPIKE
○	●	MAIL
○	●	IRON ROD
○	●	IRON PIPE
○	●	DRILL HOLE
○	■	WOOD POST
D		DEED
P		PLAT
M		MEASURED
S		SURVEYED
C		CALCULATED

I HEREBY DECLARE THAT THE ABOVE PARCEL WAS
SURVEYED DURING MAY 1989
PROPERTY LINES SHOWN ARE LOCATED FROM RECORDS
ON RECORDS AND ARE RECD LINES. BEARINGS ARE
ASSUMED FOR ANGULAR MEASUREMENT ONLY. ALL
INFORMATION SHOWN IS TRUE AND CORRECT TO THE
BEST OF MY KNOWLEDGE AND BELIEF.



James C. Homan, Jr.
JAMES C. HOMAN, JR. P.S. NO. 5972
Original signed in red ink

H.A.N.K. & ASSOCIATES, INC.

ENGINEERING • SURVEYING • PLANNING
49 SOUTH WASHINGTON STREET, Tiffin, Ohio 44883
(419) 448-0908 447-8369 294-2028 531-8345

SURVEY FOR: **ROBERT BYRD**
LOCATED IN THE SW 1/4 OF SECTION 17
EDEN TOWNSHIP, T-2-S, R-15-E,
WYANDOT COUNTY, OHIO

DRAWN BY:	CHECKED BY:	SHEET NO.
DJN 5-89	JCH 6-1-89	1
REVISIONS		JOB NO.
		89031-S

VOL 6 PAGE 524