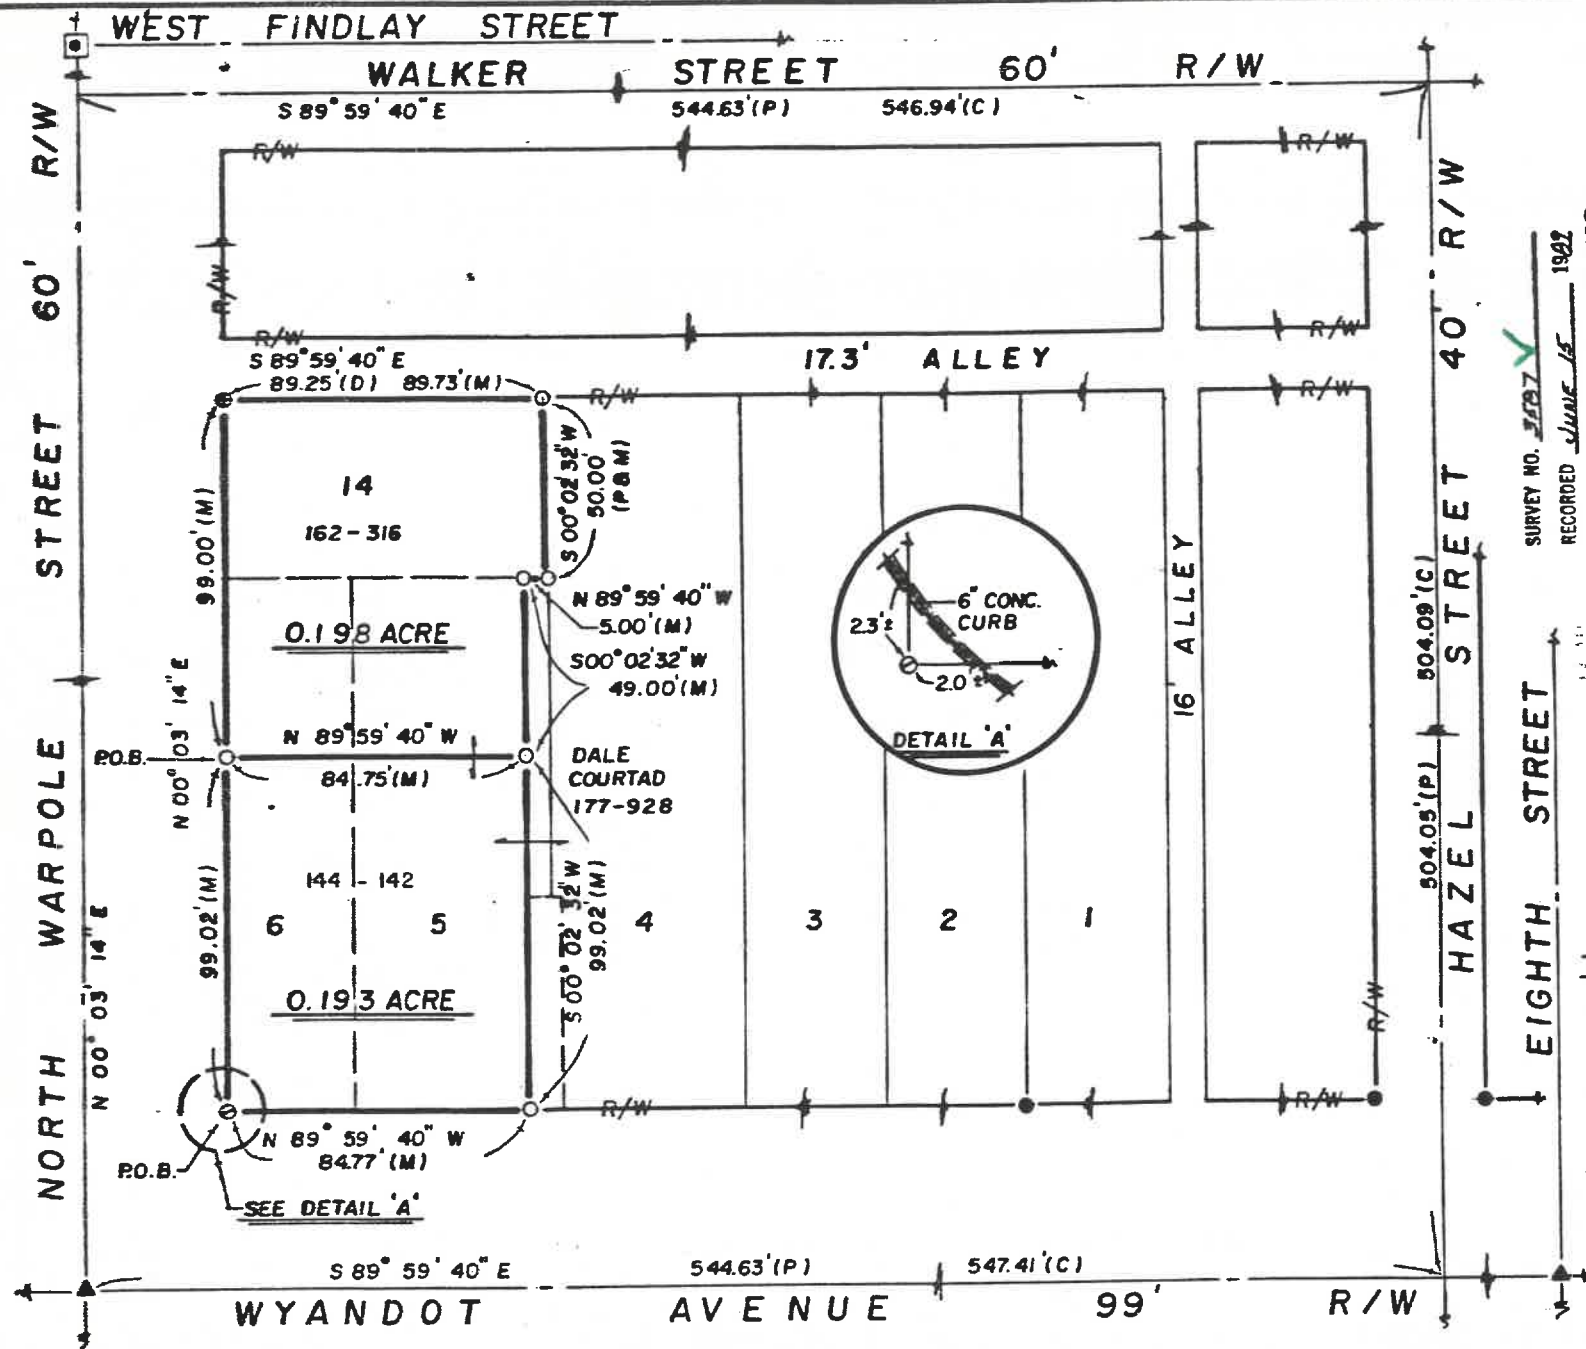


REFERENCES

DEED VOLUME & PAGE AS SHOWN

PLAT: VOLUME & PAGE:

V.3, P.69,71

V.2, P.87,92

V.4, P.397

SURVEY: VOLUME & PAGE:

V.3, P.611 #787

V.5, P.229 #1467

V.7, P.39 #3388

DEED: VOLUME & PAGE:

V.83, P.468

V.97, P.62,63

NOTE: UNABLE TO LOCATE A RECORDED EASEMENT FOR DETAIL 'A'; CITY MAY HAVE AN EASEMENT BY PRESCRIPTION.

LEGEND

SET	FOUND	DESCRIPTION
△	▲	STONE
□	■	MONUMENT BOX
○	●	CONC. MONUMENT
⊙	⊗	RAILROAD SPIKE
×	×	NAIL
•	•	IRON ROD
•	•	IRON PIPE
•	•	DRILL HOLE
•	•	WOOD POST
•	•	DEED
•	•	PLAT
•	•	MEASURED
•	•	SURVEYED
•	•	CALCULATED

I HEREBY DECLARE THAT THE ABOVE PARCEL WAS SURVEYED DURING **JUNE, 1989**.
PROPERTY LINES SHOWN ARE LOCATED FROM BEER ON RECORD AND ARE RECD LINES. BEARINGS ARE ASSUMED FOR ANGULAR MEASUREMENT ONLY. ALL INFORMATION SHOWN IS TRUE AND CORRECT TO THE BEST OF MY KNOWLEDGE AND BELIEF.



James G. Homan, Jr.
JAMES G. HOMAN, JR., P.S. NO. 56972
Original signed in red ink

H.A.N.K. & ASSOCIATES, INC.

ENGINEERING • SURVEYING • PLANNING
49 SOUTH WASHINGTON STREET, TIFFIN, OHIO 44883
(419) 448-0908 447-8369 294-2028 531-8345

SURVEY FOR: DALE COURTAD

BEING LOT 6 & 14 AND PART OF LOT 5 IN LOWRY & GAMBER'S SUBDIVISION OF T.E. GISELL'S SUBDIVISION OF OUTLOTS 177 & 178, IN THE CITY OF UPPER SANDUSKY, WYANDOT CO., OHIO

DRAWN BY:	CHECKED BY:	SHEET NO.
DJN 6-89	JGH 6-12-89	1
REVISIONS		JOB NO.
		89041-S