


RICHLAND

9-2-12


VOL. 6
PG. 535

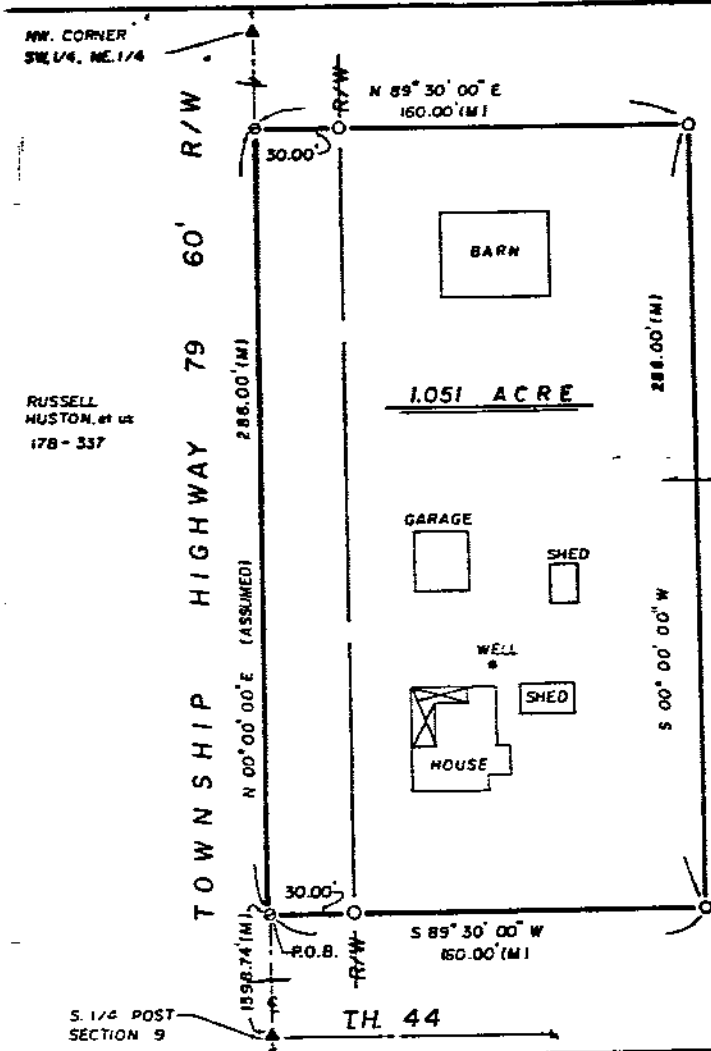

DONNA WILKERSON
183-172

NOTE: COULD NOT LOCATE
SEPTIC SYSTEM

SURVEY NO. 3600
RECORDED July 10, 1989
IN SURVEY RECORD VOL. 6 PAGE 535
TAX MAP DEPT. WYANDOT CO.

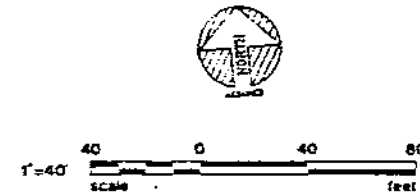

REFERENCES

DEED VOLUME & PAGE AS SHOWN
WYANDOT COUNTY STONE REFERENCES

NOTE: ALL IRON PIPE SET ARE 3/4" DIA.
WITH PERSONALIZED CAPS (J.G.H.
#6972).

SY	FLAG	DESCRIPTION
1	▲	STONE
2	■	MONUMENT STONE
3	●	CONC. MONUMENT
4	○	RAILROAD SPIKE
5	●	NAIL
6	●	IRON ROD
7	●	IRON PIPE
8	●	WELL HOLE
9	●	WOOD POST
10	●	DEED
11	●	PLAT
12	●	MEASURED
13	●	SURVEYED
14	●	CALCULATED

I HEREBY DECLARE THAT THE ABOVE PARCEL WAS
SURVEYED DURING JUNE, 1989.
THE PROPERTY LINES SHOWN ARE LOCATED FROM DEEDS
ON RECORD AND ARE TRUE LINES. SURVEYING AND
RECORDS FOR ALL LINES NEARBY SHALL BE
INFORMATION SHOWN IN THIS AND CORRECT TO THE
BEST OF MY KNOWLEDGE AND BELIEF.



James G. Houston, Jr.
JAMES G. HOUSTON, JR., P.E., S.E.
Original signed in red ink

H.A.N.K. & ASSOCIATES, INC.

ENGINEERING • SURVEYING • PLANNING
49 SOUTH WASHINGTON STREET, TIFFIN, OHIO 44883
(419) 448-0908 447-8369 294-2028 531-8345

SURVEY FOR DONNA WILKERSON

LOCATED IN THE SE 1/4 OF SECTION 9,
RICHLAND TOWNSHIP T-2-S. R-12-E,
WYANDOT COUNTY, OHIO

DRAWN BY	CHECKED BY	SHEET NO.
DJN	JGH	1
REVISIONS		JOB NO.
		89048-S

(98)

TAX MAP COPY