
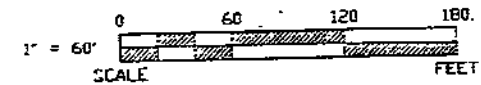


CRANE
6-2-14

TAX MAP COPY

VOL. 6
PG. 549

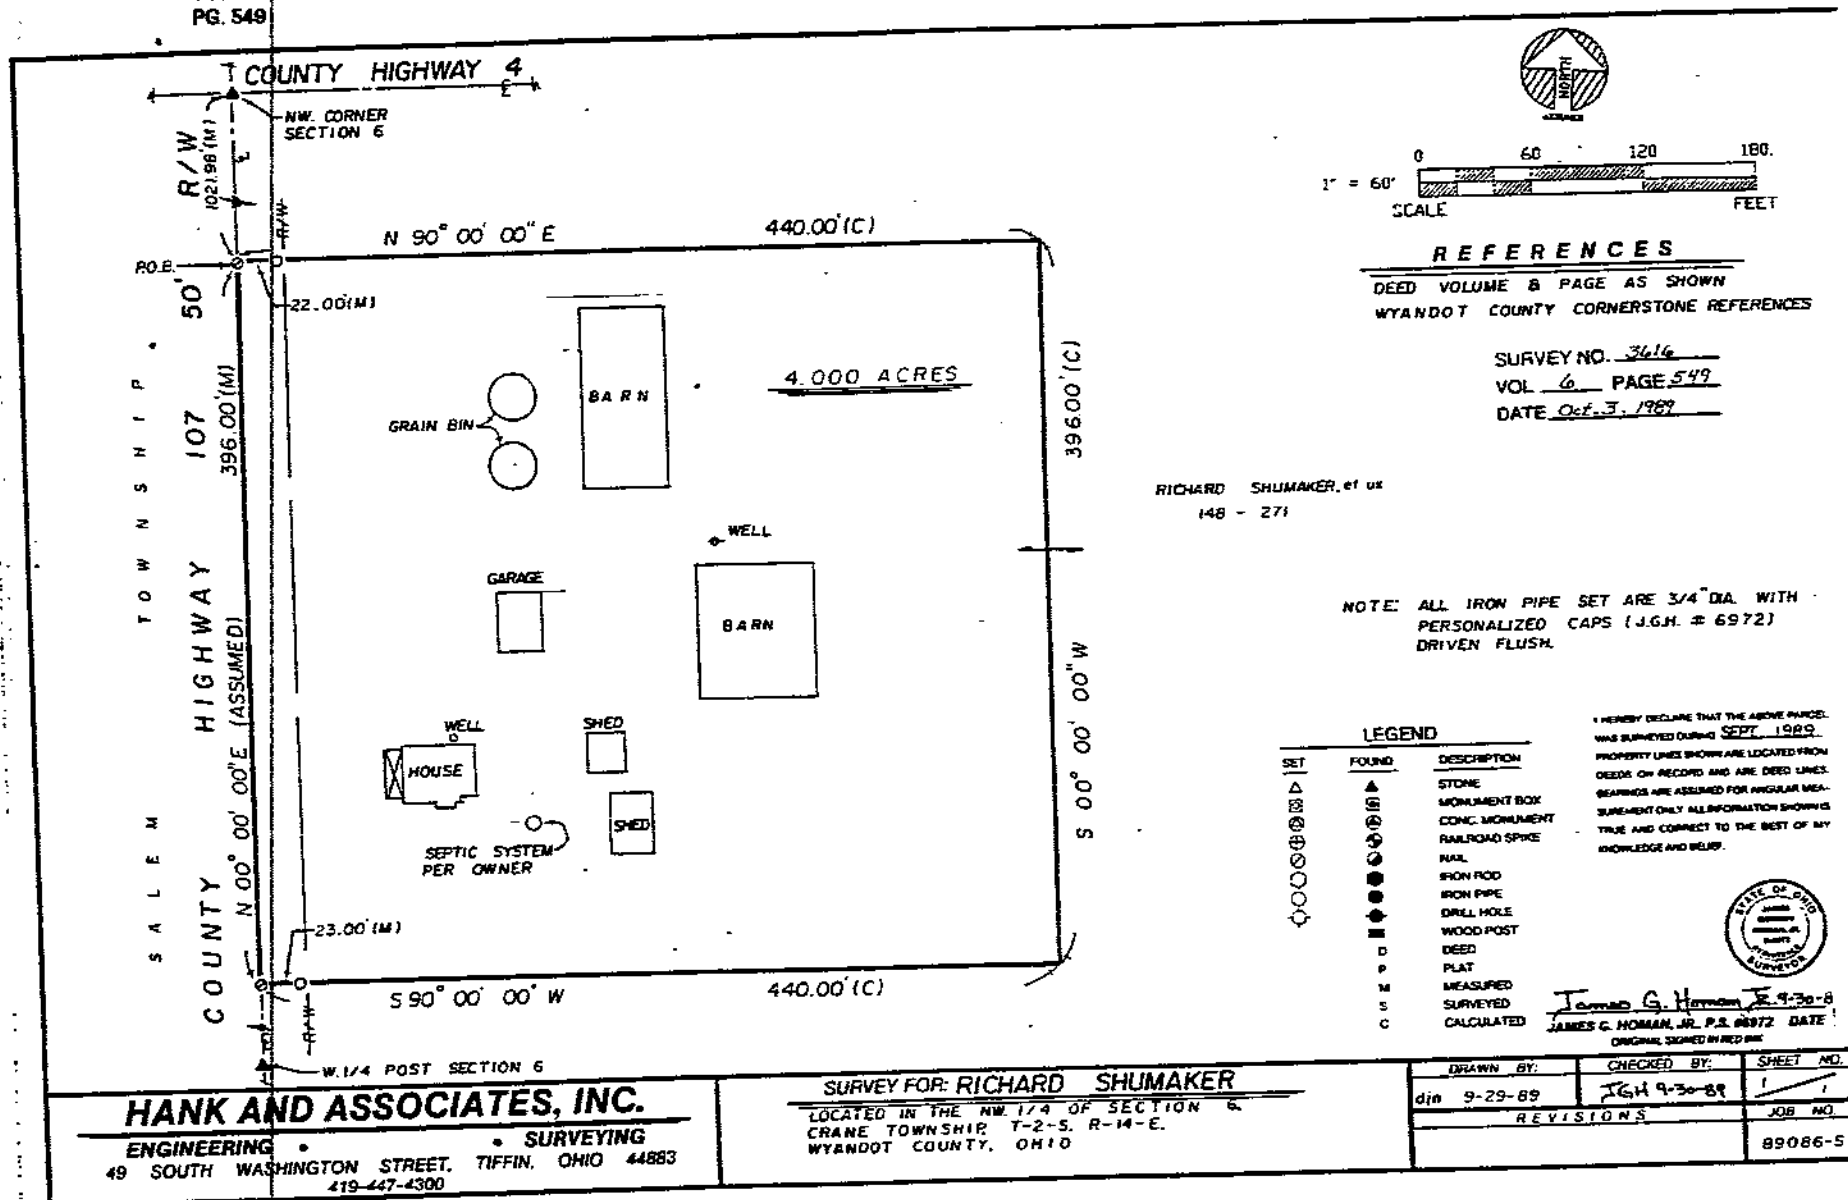

REFERENCES

DEED VOLUME & PAGE AS SHOWN
WYANDOT COUNTY CORNERSTONE REFERENCES

SURVEY NO. 3616
VOL. 6 PAGE 549
DATE Oct. 3, 1989

RICHARD SHUMAKER, et ux
148 - 271

NOTE: ALL IRON PIPE SET ARE 3/4" DIA. WITH
PERSONALIZED CAPS (J.G.H. # 6972)
DRIVEN FLUSH.

LEGEND

SET	FOUND	DESCRIPTION
△	▲	STONE
⊠	⊠	MONUMENT BOX
⊞	⊞	CONC. MONUMENT
⊙	⊙	RAILROAD SPIKE
○	○	NAIL
⊗	⊗	IRON ROD
⊕	⊕	IRON PIPE
⊖	⊖	DRELL HOLE
⊗	⊗	WOOD POST
⊙	⊙	DEED
⊕	⊕	PLAT
⊖	⊖	MEASURED
⊗	⊗	SURVEYED
⊕	⊕	CALCULATED

I HEREBY DECLARE THAT THE ABOVE PARCEL
WAS SURVEYED DURING SEPT. 1989
PROPERTY LINES SHOWN ARE LOCATED FROM
DEEDS ON RECORD AND ARE DEED LINES.
BEARINGS ARE ASSUMED FOR ANGULAR MEASUREMENT ONLY ALL INFORMATION SHOWN IS
TRUE AND CORRECT TO THE BEST OF MY
KNOWLEDGE AND BELIEF.



James G. Homan, Jr. 9-30-89
JAMES G. HOMAN, JR., P.S. 19872 DATE
ORIGINAL SIGNED BY RED INK

HANK AND ASSOCIATES, INC.
ENGINEERING • SURVEYING
49 SOUTH WASHINGTON STREET, TIFFIN, OHIO 44883
419-447-4300

SURVEY FOR: **RICHARD SHUMAKER**
LOCATED IN THE NW 1/4 OF SECTION 6,
CRANE TOWNSHIP, T-2-S, R-14-E,
WYANDOT COUNTY, OHIO

DRAWN BY:	CHECKED BY:	SHEET NO.
din 9-29-89	JGH 9-30-89	1
REVISIONS		JOB NO.
		89086-5