


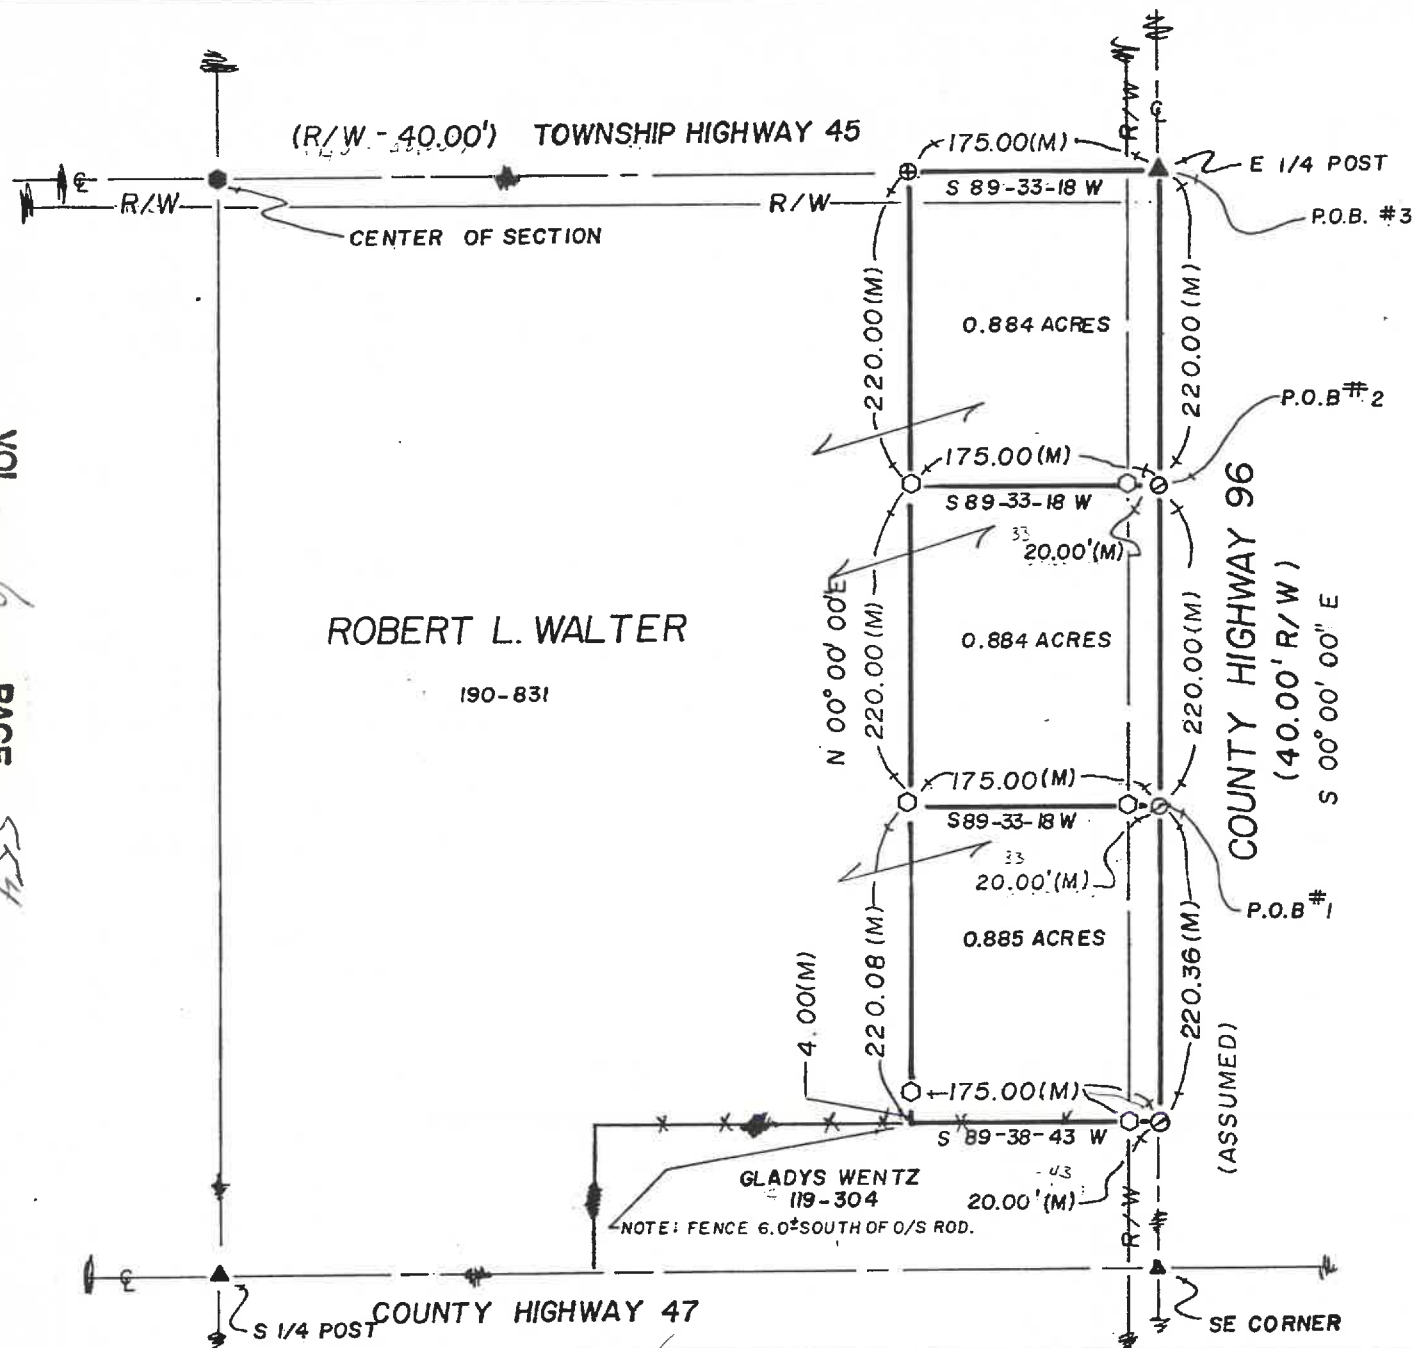

1"=100'
scale 100 0 ASSUMED 100 200 feet

REFERENCES

DEED VOLUME & PAGE AS SHOWN
WYANDOT COUNTY CORNERSTONE REFERENCES

SURVEY NO. 3625

VOL 6 PAGE 554

DATE Nov 15, 1989

NOTE: ALL IRON ROD SET ARE 1/2" DIA.
WITH PERSONALIZED CAPS (J.G.H. #6972)
DRIVE'N FLUSH.

LEGEND

SET	FOUND	DESCRIPTION
△	▲	STONE
□	■	MONUMENT BOX
⊕	⊕	CONC. MONUMENT
⊗	⊗	RAILROAD SPIKE
○	●	NAIL
○	●	IRON ROD
○	●	IRON PIPE
○	●	DRILL HOLE
○	■	WOOD POST
D		DEED
P		PLAT
M		MEASURED
S		SURVEYED
C		CALCULATED

I HEREBY DECLARE THAT THE ABOVE PARCEL
WAS SURVEYED DURING NOV 1989.
PROPERTY LINES SHOWN ARE LOCATED FROM
DEEDS ON RECORD AND ARE DEED LINES.
BEARINGS ARE ASSUMED FOR ANGULAR MEASUREMENT ONLY. ALL INFORMATION SHOWN IS TRUE AND CORRECT TO THE BEST OF MY KNOWLEDGE AND BELIEF.



James G. Homan, Jr.
JAMES G. HOMAN, JR., P.S. #6972 DATE 11-08-89
ORIGINAL SIGNED IN RED INK

HANK AND ASSOCIATES, INC.

ENGINEERING • SURVEYING
49 SOUTH WASHINGTON STREET, TIFFIN, OHIO 44883
419-447-4300

SURVEY FOR: ROBERT L. WALTERS

LOCATED IN THE SE. 1/4 OF SECTION 18,
SALEM TOWNSHIP, T-2-S, R-13-E,
WYANDOT COUNTY, OHIO

DRAWN BY:	CHECKED BY:	SHEET NO.
frs 11-6-89	<u>234 11-08-89</u>	<u>1</u>
REVISIONS		JOB NO.
		89104 - S