


ASSUMED

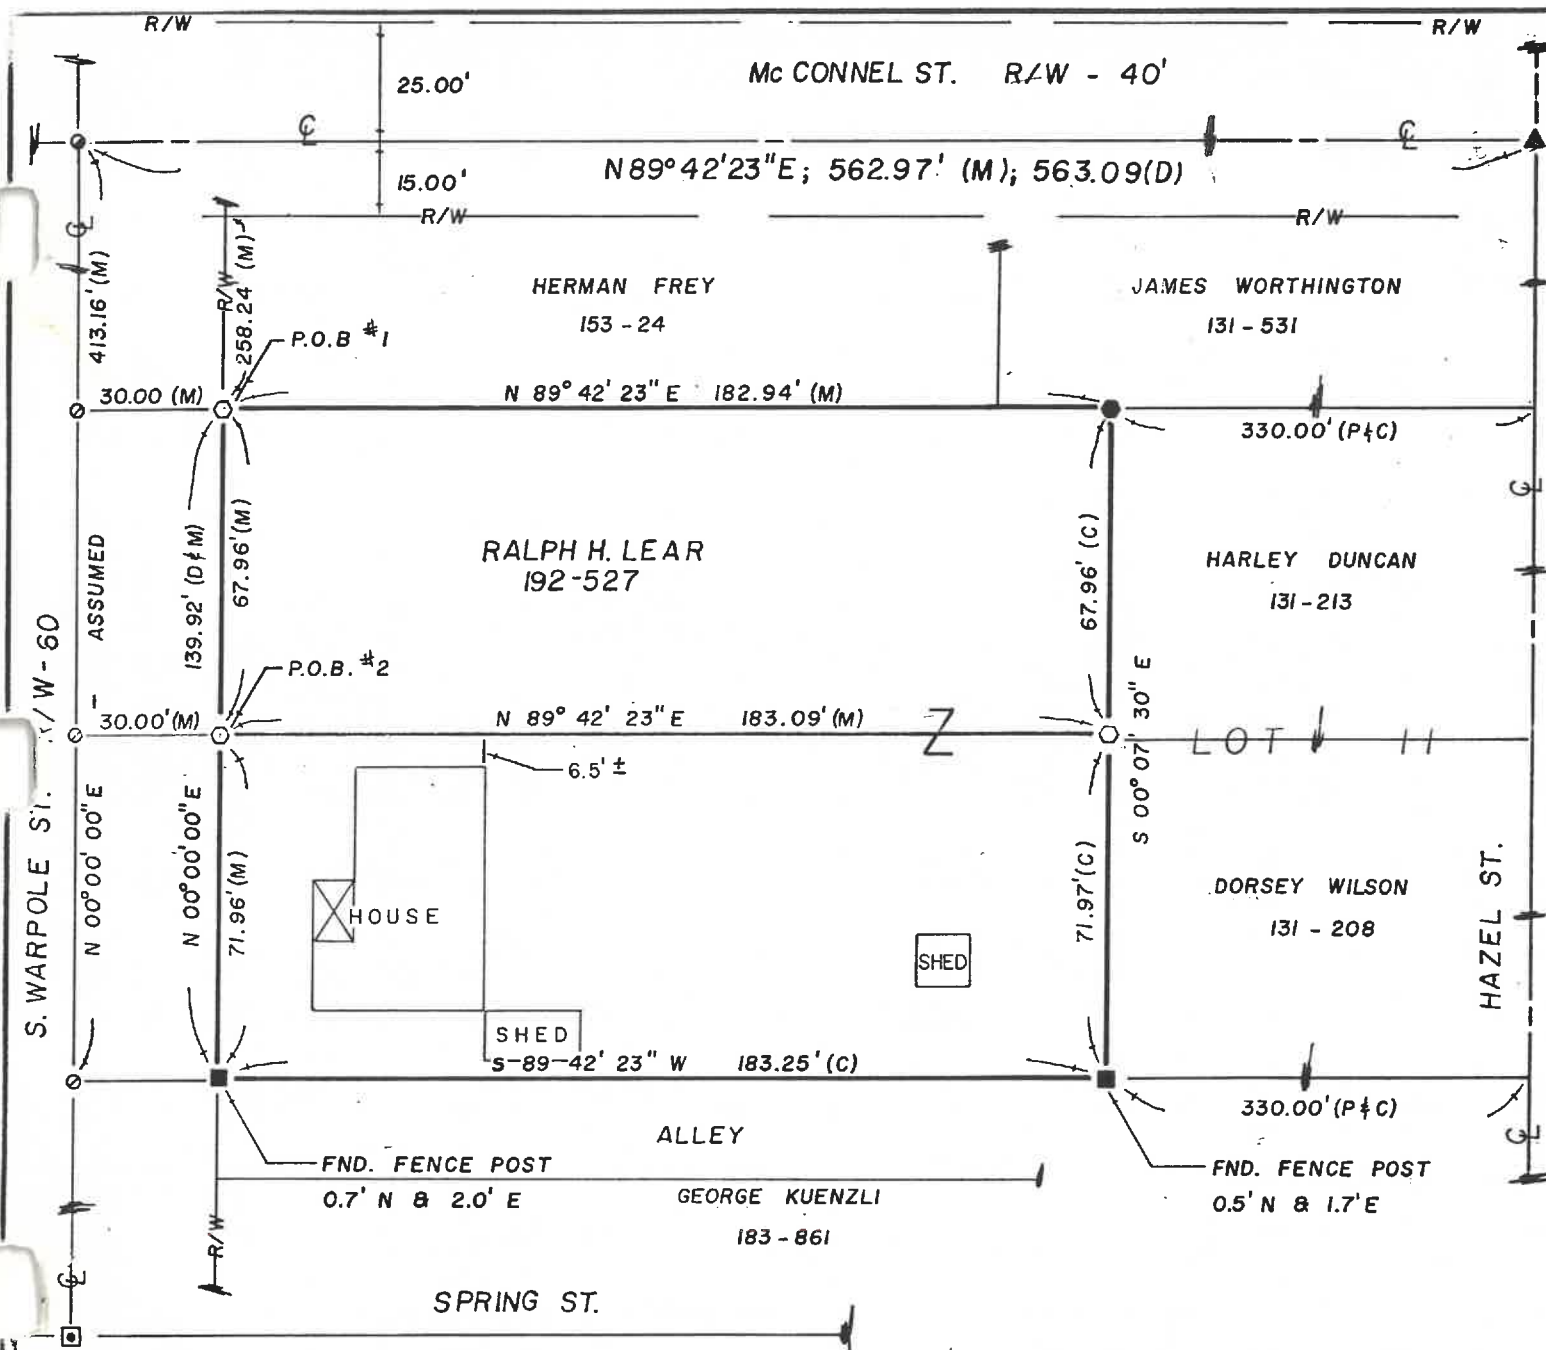

REFERENCES

DEED VOLUMES & PAGES AS SHOWN.
PLAT BOOK 2, PAGES 121, 194.
SURVEY VOLUME 6, PAGE 304

SURVEY NO. 3628
VOL 6 PAGE 557
DATE Nov 22, 1989

NOTE

ALL IRON ROD SET ARE 1/2" DIA. WITH
PERSONALIZED CAPS (J.G.H. #6972)
DRIVEN FLUSH.

LEGEND

SET	FOUND	DESCRIPTION
△	▲	STONE
□	■	MONUMENT BOX
⊕	⊙	CONC. MONUMENT
⊗	⊗	RAILROAD SPIKE
○	●	NAIL
○	●	IRON ROD
○	●	IRON PIPE
○	●	DRILL HOLE
○	■	WOOD POST
D	D	DEED
P	P	PLAT
M	M	MEASURED
S	S	SURVEYED
C	C	CALCULATED

I HEREBY DECLARE THAT THE ABOVE PARCEL
WAS SURVEYED DURING NOV. 1989.
PROPERTY LINES SHOWN ARE LOCATED FROM
DEEDS ON RECORD AND ARE DEED LINES.
BEARINGS ARE ASSUMED FOR ANGULAR MEASUREMENT ONLY. ALL INFORMATION SHOWN IS
TRUE AND CORRECT TO THE BEST OF MY
KNOWLEDGE AND BELIEF.



James G. Homan, Jr. 11-08-89
JAMES G. HOMAN, JR., P.S. #6972 DATE
ORIGINAL SIGNED IN RED INK

HANK AND ASSOCIATES, INC.

ENGINEERING • SURVEYING
49 SOUTH WASHINGTON STREET, TIFFIN, OHIO 44883
419-447-4300

SURVEY FOR: RALPH LEAR

LOCATED IN THE SOUTHEAST 1/4 OF SECTION
31, CRANE TWP, T2S, R14E, CITY OF UPPER
SANDUSKY, WYANDOT COUNTY, OHIO

DRAWN BY:	CHECKED BY:	SHEET NO.
VBK 11-7-89	JGH 11-08-89	1/1
REVISIONS		JOB NO.
		89096-S