
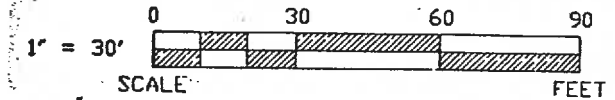


DON REYNOLDS
191 - 851

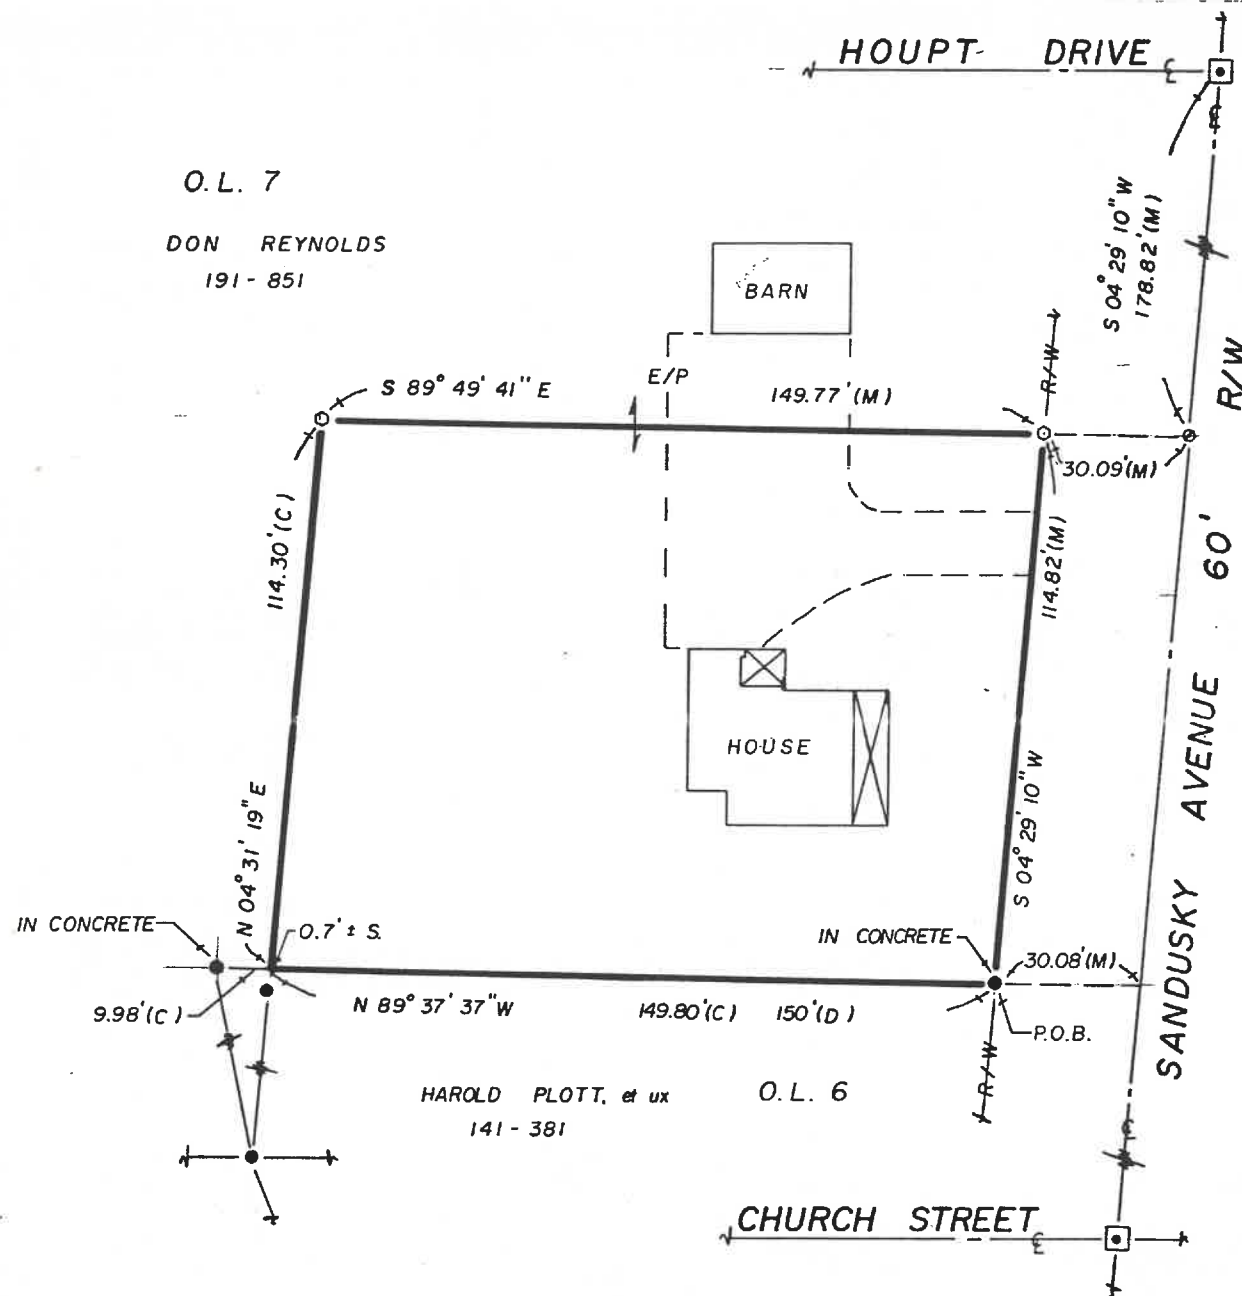

REFERENCES

DEED VOLUME & PAGE AS SHOWN

SURVEY VOLUME & PAGE:

V. 4, P. 531

SURVEY NO. 3630 ✓

VOL 6 PAGE 559

DATE Nov 22, 1989

NOTE: ALL IRON ROD SET ARE 1/2" DIA. WITH
PERSONALIZED CAPS (J.G.H. # 6972)
DRIVEN FLUSH.

LEGEND

SET	FOUND	DESCRIPTION
		STONE
		MONUMENT BOX
		CONC. MONUMENT
		RAILROAD SPIKE
		NAIL
		IRON ROD
		IRON PIPE
		DRILL HOLE
		WOOD POST
	D	DEED
	P	PLAT
	M	MEASURED
	S	SURVEYED
	C	CALCULATED

I HEREBY DECLARE THAT THE ABOVE PARCEL
WAS SURVEYED DURING NOV. 1989.
PROPERTY LINES SHOWN ARE LOCATED FROM
DEEDS ON RECORD AND ARE DEED LINES.
BEARINGS ARE ASSUMED FOR ANGULAR MEASUREMENT ONLY. ALL INFORMATION SHOWN IS
TRUE AND CORRECT TO THE BEST OF MY
KNOWLEDGE AND BELIEF.



James G. Homan 11-16-89
D JAMES G. HOMAN, JR., P.S. #6972 DATE
ORIGINAL SIGNED IN RED INK

HANK AND ASSOCIATES, INC.

SURVEY FOR: **RICHARD COURTAD**

BEING PART OF LOT 7 IN JOHN MONNETT'S ADDITION
TO THE CITY OF UPPER SANDUSKY,
WYANDOT COUNTY, OHIO

ENGINEERING • SURVEYING
49 SOUTH WASHINGTON STREET, TIFFIN, OHIO 44883
419-447-4300

DRAWN BY:

CHECKED BY:

SHEET NO.

djn 11-9-89

REVISIONS

JOB NO.

89108-S