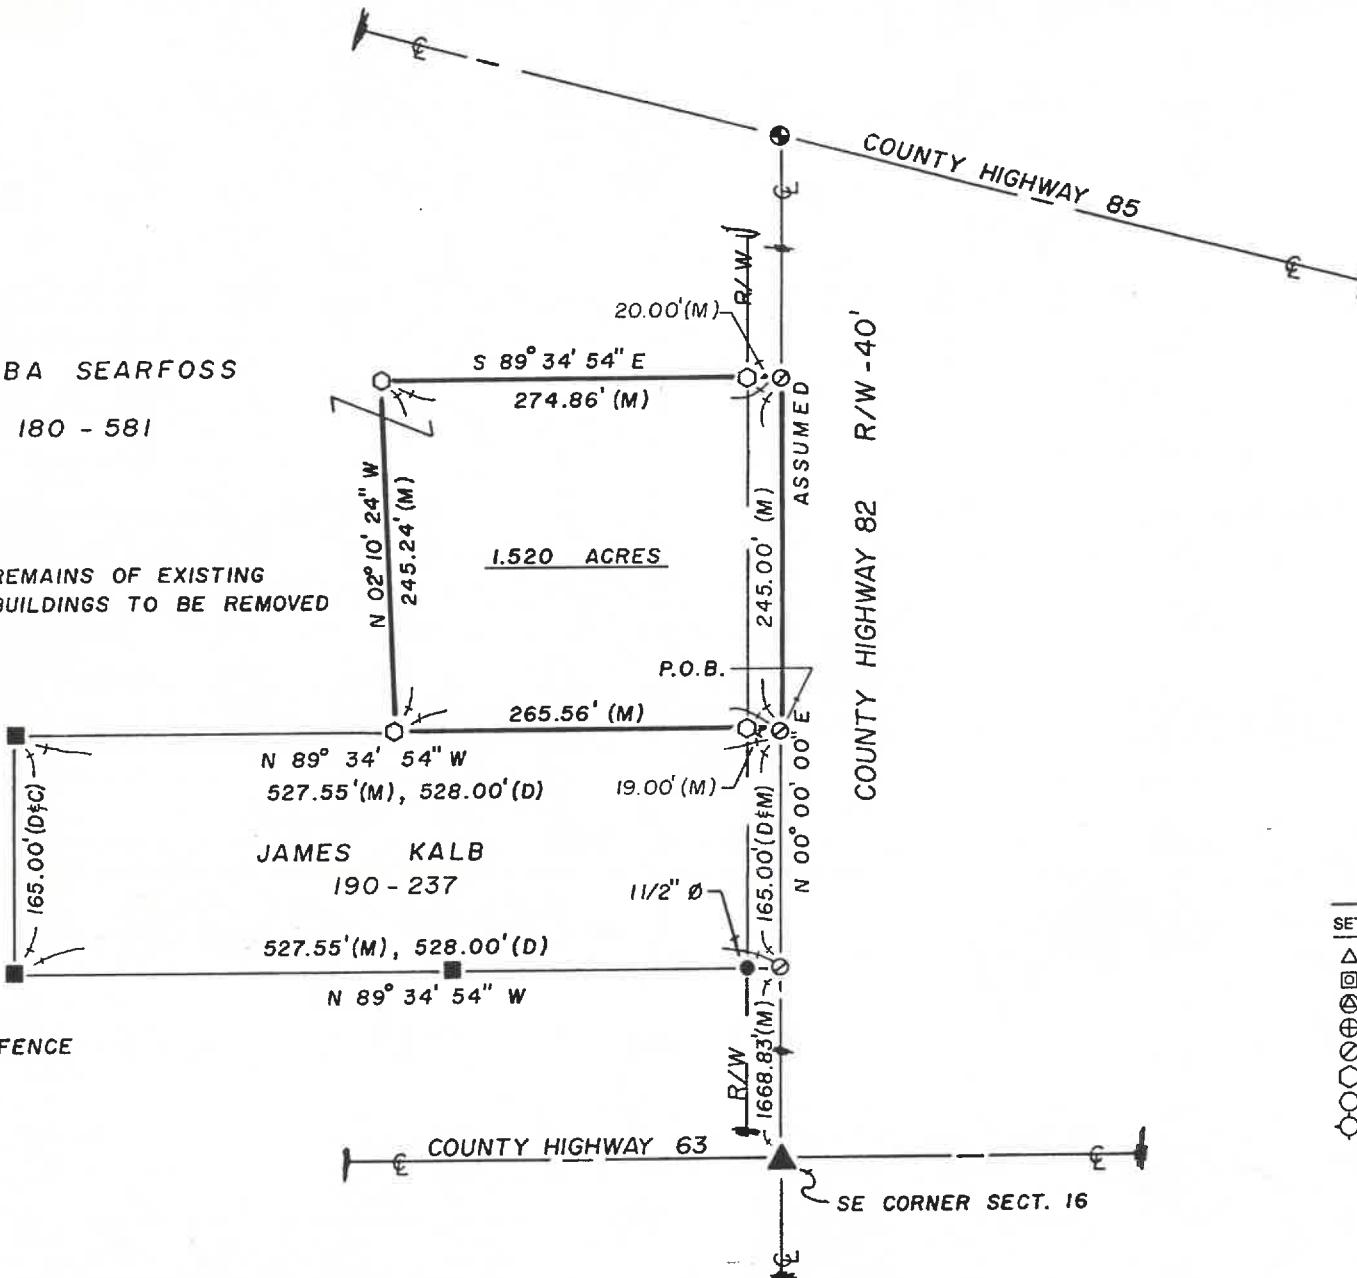


REBA SEARFOSS
180 - 581REMAINS OF EXISTING
BUILDINGS TO BE REMOVEDREFERENCESDEED VOLUME AND PAGE AS SHOWN.
WYANDOT COUNTY CORNERSTONE
REFERENCES.NOTE: ALL IRON ROD SET ARE 1/2"
DIAMETER WITH PERSONALIZED CAPS
(J.G.H. #6972) DRIVEN FLUSH.

SURVEY NO. 3631 ✓

VOL 6 PAGE 560

DATE Dec. 4, 1989

LEGEND		
SET	FOUND	DESCRIPTION
△	□	STONE
○	△	MONUMENT BOX
◎	○	CONC. MONUMENT
⊕	◎	RAILROAD SPIKE
⊖	⊕	NAIL
■	⊖	IRON ROD
□	■	IRON PIPE
○	□	DRILL HOLE
●	○	WOOD POST
D	●	DEED
P	D	PLAT
M	P	MEASURED
S	M	SURVEYED
C	S	CALCULATED

I HEREBY DECLARE THAT THE ABOVE PARCEL
WAS SURVEYED DURING NOV. 1989.
PROPERTY LINES SHOWN ARE LOCATED FROM
DEEDS ON RECORD AND ARE DEED LINES.
BEARINGS ARE ASSUMED FOR ANGULAR MEA-
SUREMENT ONLY. ALL INFORMATION SHOWN IS
TRUE AND CORRECT TO THE BEST OF MY
KNOWLEDGE AND BELIEF.



James G. Homan, Jr. 11-29-89
JAMES G. HOMAN, JR., P.S. #6972 DATE
ORIGINAL SIGNED IN RED INK

HANK AND ASSOCIATES, INC.

ENGINEERING • SURVEYING
49 SOUTH WASHINGTON STREET, TIFFIN, OHIO 44883
419-447-4300

SURVEY FOR: REBA SEARFOSS

LOCATED IN THE NORTH PART OF THE EAST 1/2 OF THE
SOUTHEAST 1/4 OF SECTION 16, T3S, R12E, WYANDOT CO., OH.

DRAWN BY:	CHECKED BY:	SHEET NO.
VBK 11/29/89	JGH 11-29-89	1 / 1
REVISIONS		JOB NO.
89109 - S		