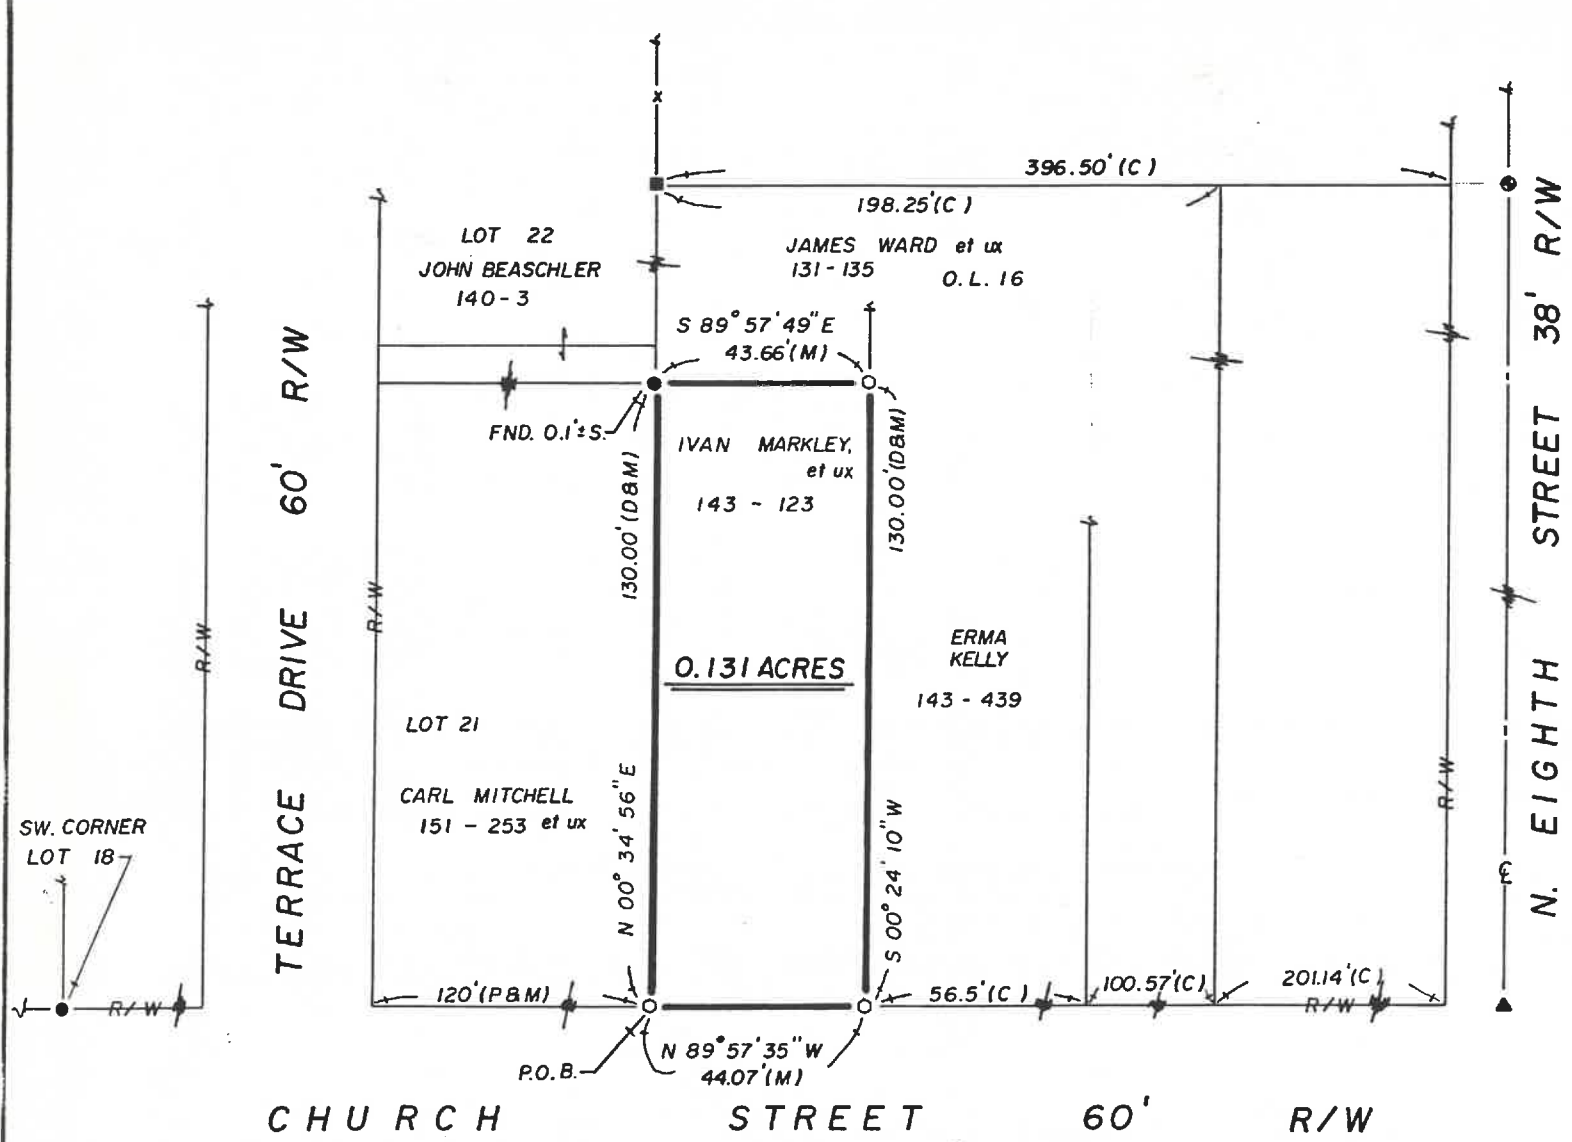


REFERENCES

DEED VOLUME 8 PAGE AS SHOWN
SURVEY VOLUME 2, PAGE 73
SURVEY # 804
SURVEY FOR J. WARD BY J.B. WEININGER, NOV. 1970
GLENHAVEN SUBDIVISION # 1
JOHN MONNETT'S ADDITION

SURVEY NO. 3633 ✓
VOL 6 PAGE 562
DATE DEC 4, 1989

NOTE: ALL IRON ROD ARE 1/2" DIA. WITH
PERSONALIZED CAPS (J.G.H. #6972)
DRIVEN FLUSH.

LEGEND

SET	FOUND	DESCRIPTION
△	▲	STONE
⊠	⊠	MONUMENT BOX
⊙	⊙	CONC. MONUMENT
⊕	⊕	RAILROAD SPIKE
⊗	⊗	NAIL
⊘	⊘	IRON ROD
○	○	IRON PIPE
●	●	DRILL HOLE
■	■	WOOD POST
D	D	DEED
P	P	PLAT
M	M	MEASURED
S	S	SURVEYED
C	C	CALCULATED

I HEREBY DECLARE THAT THE ABOVE PARCEL
WAS SURVEYED DURING NOV. 1989.
PROPERTY LINES SHOWN ARE LOCATED FROM
DEEDS ON RECORD AND ARE DEED LINES.
BEARINGS ARE ASSUMED FOR ANGULAR MEA-
SUREMENT ONLY. ALL INFORMATION SHOWN IS
TRUE AND CORRECT TO THE BEST OF MY
KNOWLEDGE AND BELIEF.



James G. Homan, Jr. 11-29-89
JAMES G. HOMAN, JR., P.S. #6972 DATE
ORIGINAL SIGNED IN RED INK

HANK AND ASSOCIATES, INC.

ENGINEERING • SURVEYING
49 SOUTH WASHINGTON STREET, TIFFIN, OHIO 44883
419-447-4300

SURVEY FOR: **EVIE MARKLEY**

BEING PART OF O.L. 16 OF JOHN MONNETT'S ADDITION
TO THE CITY OF UPPER SANDUSKY,
WYANDOT COUNTY, OHIO

DRAWN BY:	CHECKED BY:	SHEET NO.
djn 11-21-89	JGH 11-29-89	1/1
REVISIONS		JOB NO.
		89098-S