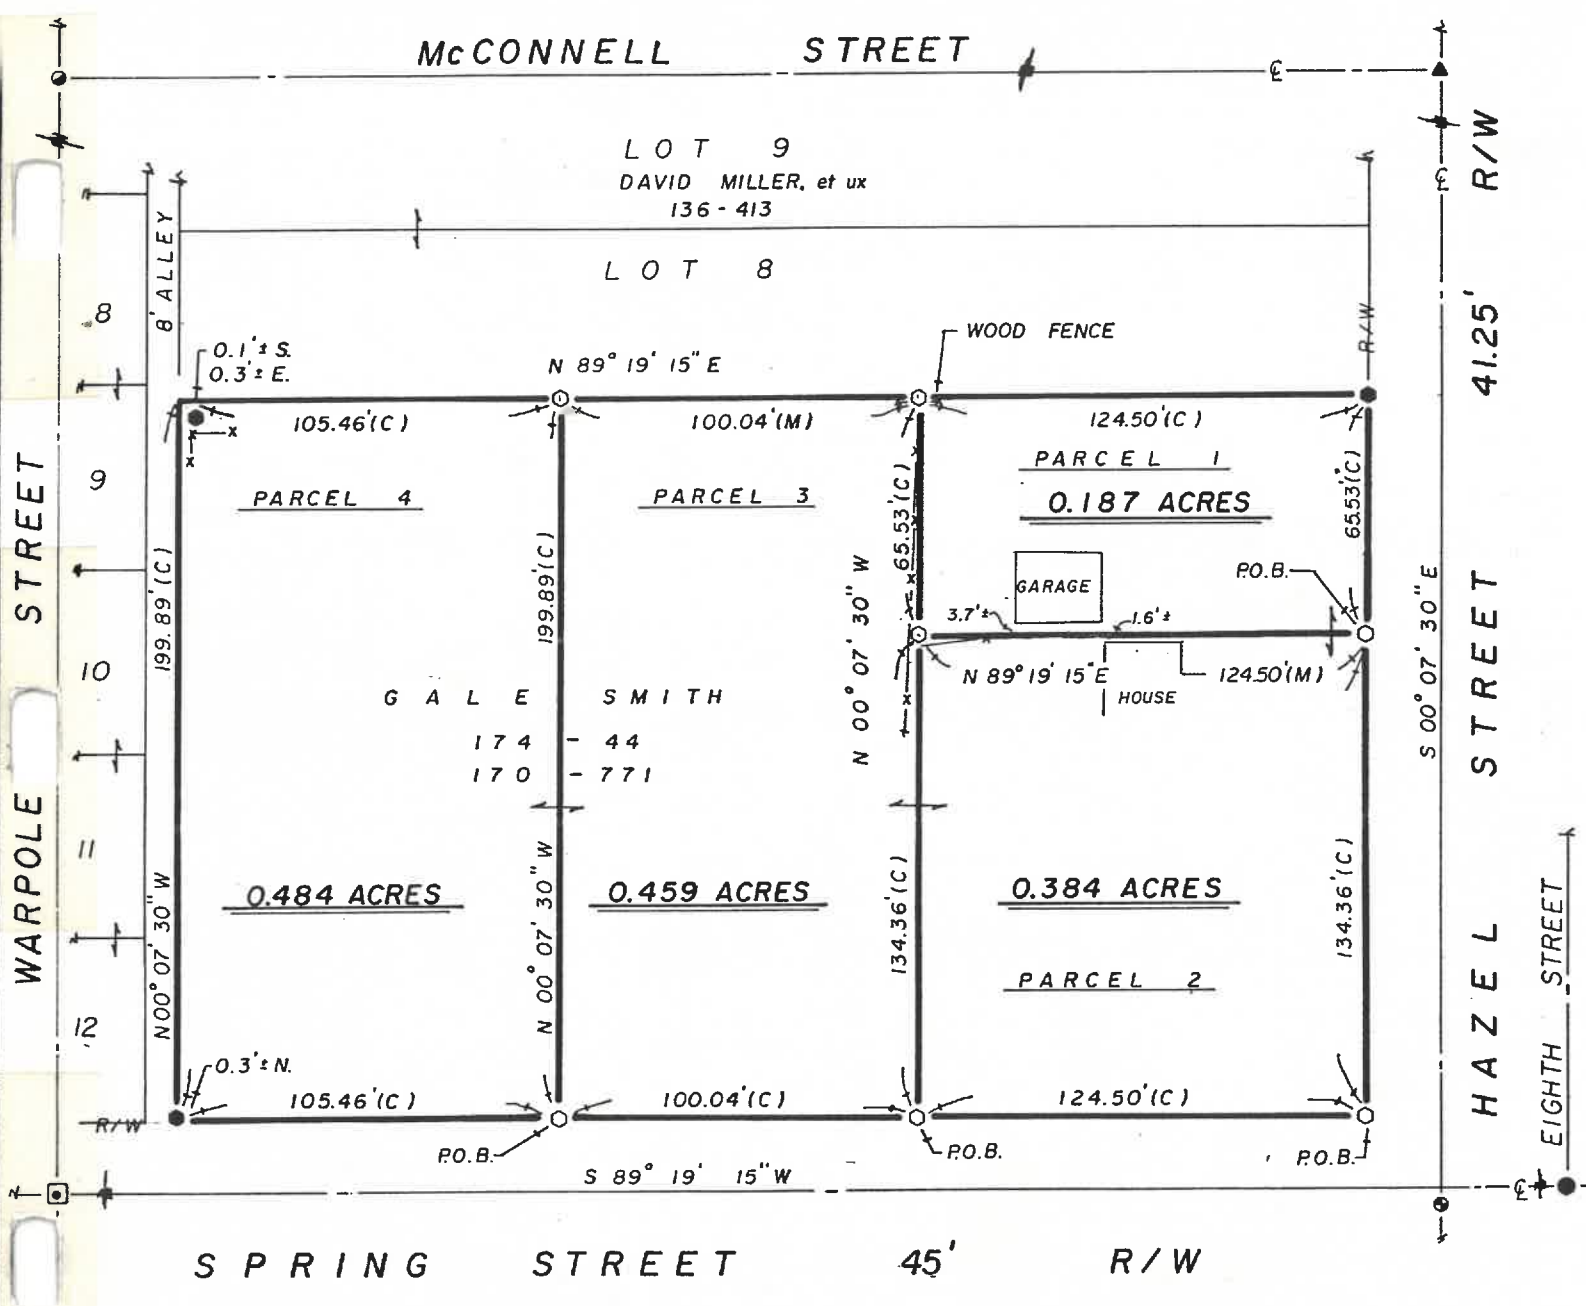


REFERENCES

DEED VOLUME & PAGE AS SHOWN
 SURVEY FOR G. SMITH BY J. MORRIS, 10-79
 PLAT VOLUME & PAGE:
 V. 2, P. 121
 V. 2, P. 194
 SURVEY VOLUME & PAGE:
 V. 3, P. 425

SURVEY NO. 3638 ✓
 VOL. 6 PAGE 564
 DATE JAN 2, 1990

NOTE: ALL IRON ROD SET ARE 1/2" DIA. WITH PERSONALIZED CAPS (J.G.H. # 6972) DRIVEN FLUSH.

LEGEND

SET	FOUND	DESCRIPTION
△	▲	STONE
□	■	MONUMENT BOX
⊕	⊕	CONC. MONUMENT
⊙	⊙	RAILROAD SPIKE
⊗	⊗	NAIL
○	●	IRON ROD
○	●	IRON PIPE
○	●	DRILL HOLE
○	●	WOOD POST
D		DEED
P		PLAT
M		MEASURED
S		SURVEYED
C		CALCULATED

I HEREBY DECLARE THAT THE ABOVE PARCEL WAS SURVEYED DURING DEC. 1989. PROPERTY LINES SHOWN ARE LOCATED FROM DEEDS ON RECORD AND ARE DEED LINES. BEARINGS ARE ASSUMED FOR ANGULAR MEASUREMENT ONLY. ALL INFORMATION SHOWN IS TRUE AND CORRECT TO THE BEST OF MY KNOWLEDGE AND BELIEF.



James G. Homan, Jr. 12-21-89
 JAMES G. HOMAN, JR., P.S. #6972 DATE
 ORIGINAL SIGNED IN RED INK

HANK AND ASSOCIATES, INC.

ENGINEERING • SURVEYING
 49 SOUTH WASHINGTON STREET, TIFFIN, OHIO 44883
 419-447-4300

SURVEY FOR: GALE SMITH

BEING PART OF LOT 8 IN THE CITY OF UPPER SANDUSKY, SE 1/4 OF SECTION 31, CRANE TOWNSHIP, T-2-S, R-14-E, WYANDOT COUNTY, OHIO

DRAWN BY:	CHECKED BY:	SHEET NO.
djn 12-19-89		1 / 1
REVISIONS		JOB NO.
		89120-S

VOL. 6 PAGE 564