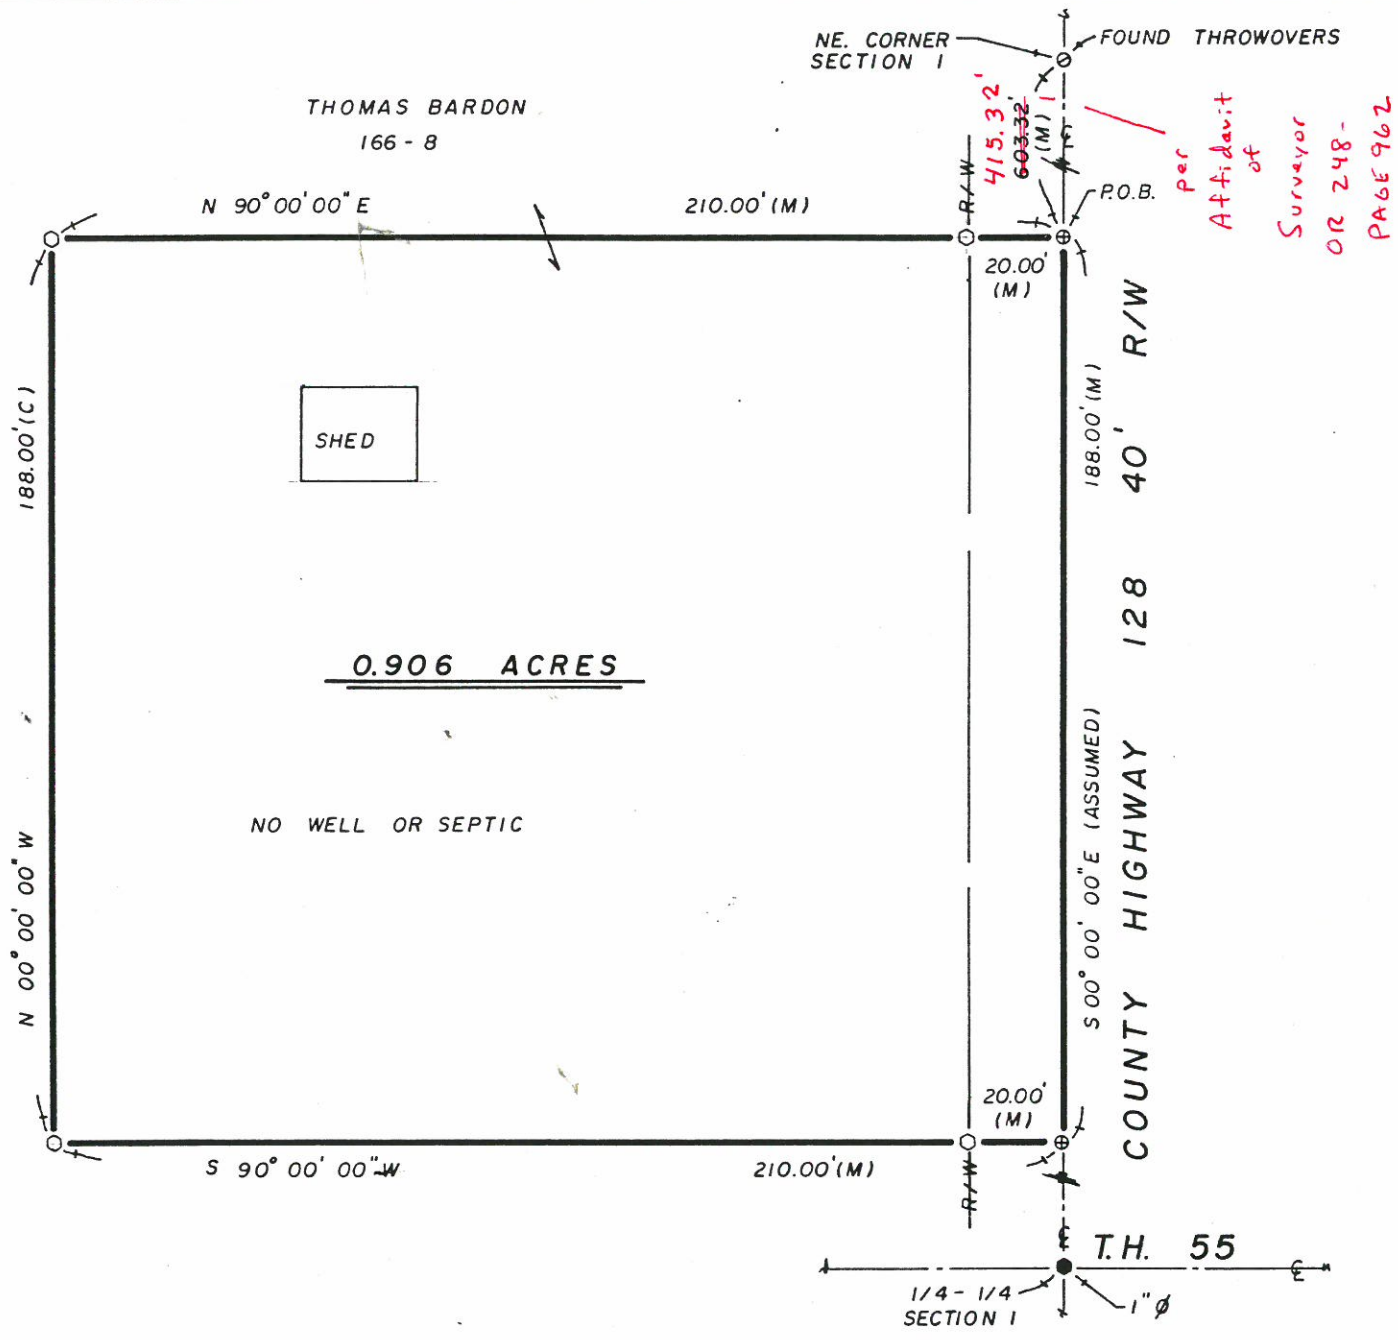


REFERENCES
 DEED VOLUME & PAGE AS SHOWN

SURVEY NO. 3255 ✓
 VOL 6 PAGE 578
 DATE MAR 19, 1990

NOTE: ALL IRON ROD SET ARE 1/2" DIA. W/
 PERSONALIZED CAPS (J.G.H. #6972)
 DRIVEN FLUSH.

LEGEND		
SET	FOUND	DESCRIPTION
△	▲	STONE
□	■	MONUMENT BOX
⊕	⊙	CONC. MONUMENT
⊗	⊛	RAILROAD SPIKE
⊙	●	NAIL
⊗	●	IRON ROD
⊙	●	IRON PIPE
⊗	●	DRILL HOLE
⊙	■	WOOD POST
⊗	D	DEED
⊙	P	PLAT
⊗	M	MEASURED
⊙	S	SURVEYED
⊗	C	CALCULATED
⊙	∅	DIAMETER

I HEREBY DECLARE THAT THE ABOVE PARCEL
 WAS SURVEYED DURING MARCH, 1990
 PROPERTY LINES SHOWN ARE LOCATED FROM
 DEEDS ON RECORD AND ARE DEED LINES.
 BEARINGS ARE ASSUMED FOR ANGULAR MEA-
 SUREMENT ONLY. ALL INFORMATION SHOWN IS
 TRUE AND CORRECT TO THE BEST OF MY
 KNOWLEDGE AND BELIEF.



James G. Homan, Jr. 3-16-90
 JAMES G. HOMAN, JR., P.S. #6972 DATE
 ORIGINAL SIGNED IN RED INK

HANK AND ASSOCIATES, INC.
 ENGINEERING • SURVEYING
 49 SOUTH WASHINGTON STREET, TIFFIN, OHIO 44883
 419-447-4300

SURVEY FOR: DAVE MOONEY
 LOCATED IN THE NE. 1/4 OF SECTION 1,
 CRANE TOWNSHIP, T-3-S, R-14-E,
 WYANDOT COUNTY, OHIO

DRAWN BY:	CHECKED BY:	SHEET NO.
DJN 3-15-90	JGH 3-16-90	1
REVISIONS		JOB NO.
		90016-S

VOL. 6 PAGE 578