



MARY DIRMAYER  
169 - 18

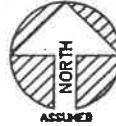

1' = 40' 40 0 40 80  
SCALE FEET

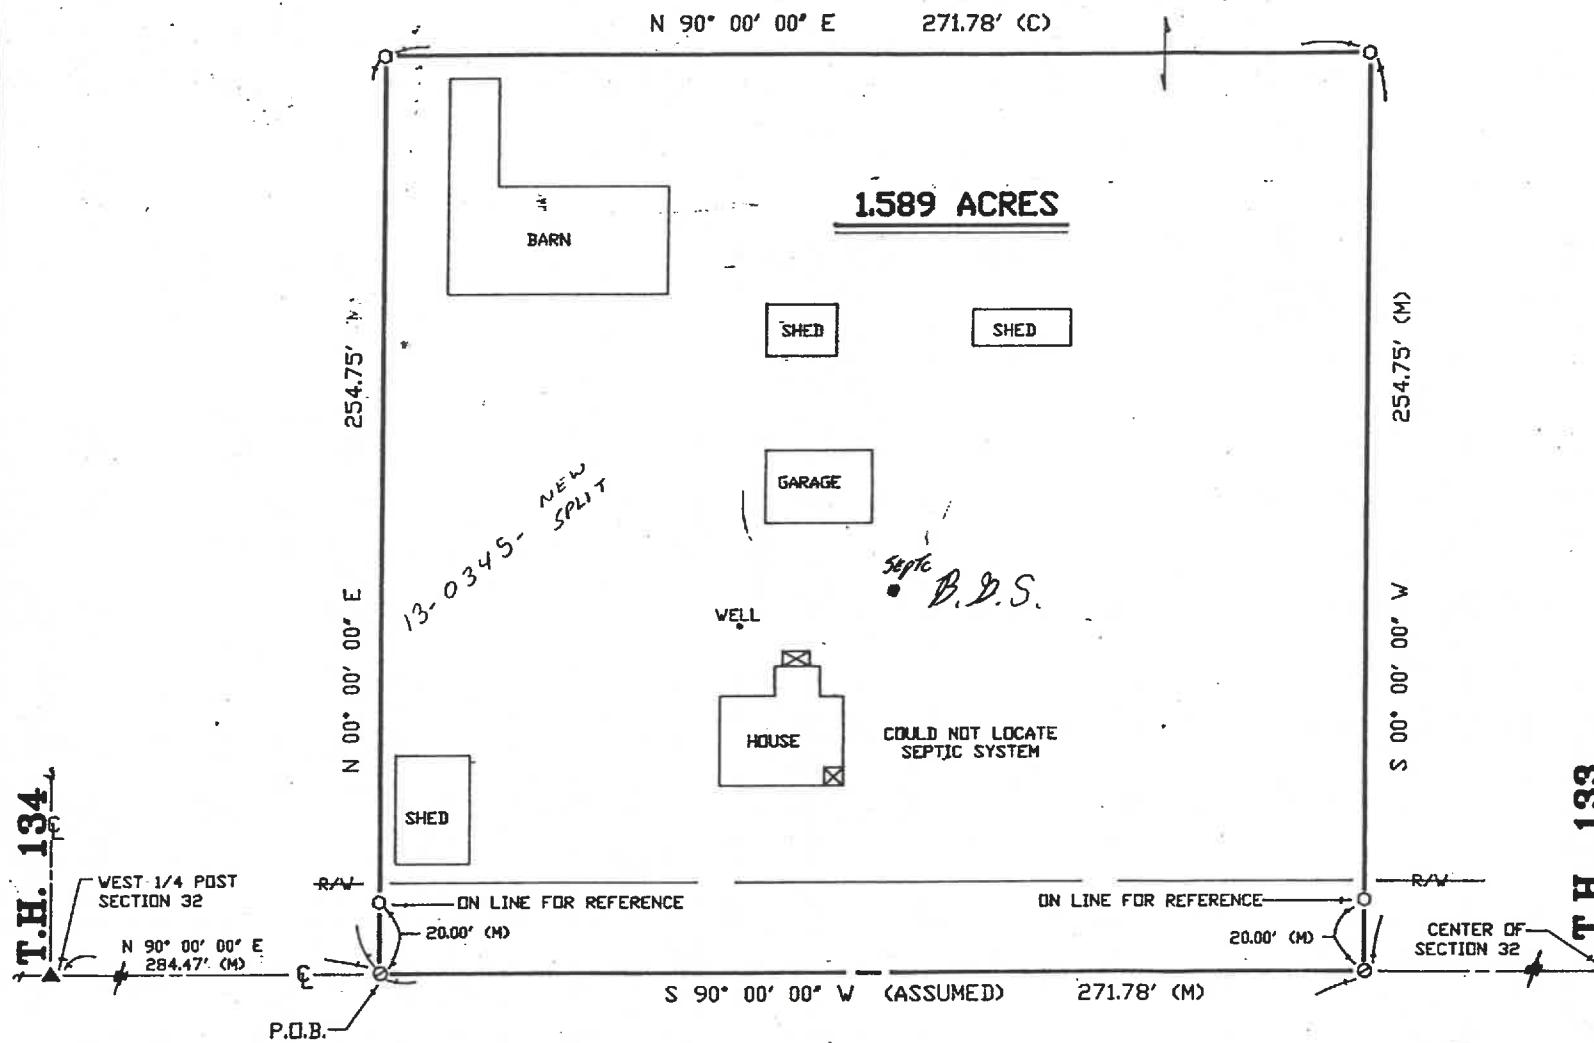

STATE

ROUTE

182

50'

R/W

HANK AND ASSOCIATES, INC.

ENGINEERING • SURVEYING  
49 SOUTH WASHINGTON STREET, TIFFIN, OHIO 44883  
419-447-4300

SURVEY FOR: MARY DIRMAYER

LOCATED IN THE NW. 1/4 OF SECTION 32,  
EDEN TOWNSHIP, T-2-S, R-15-E,  
WYANDOT COUNTY, OHIO

DRAWN BY:	CHECKED BY:	SHEET NO.
JUN 7-12-90	J.G. 7-13-90	1 / 1
REVISIONS		JOB NO.



James G. Homan, Jr., P.S. #6972 DATE  
ORIGINAL SIGNED IN RED INK

90073-S  
(342)