




1' = 40' 40 0 40 80
SCALE FEET

C O U N T Y H I G H W A Y 6 4 4 0 ' R / W

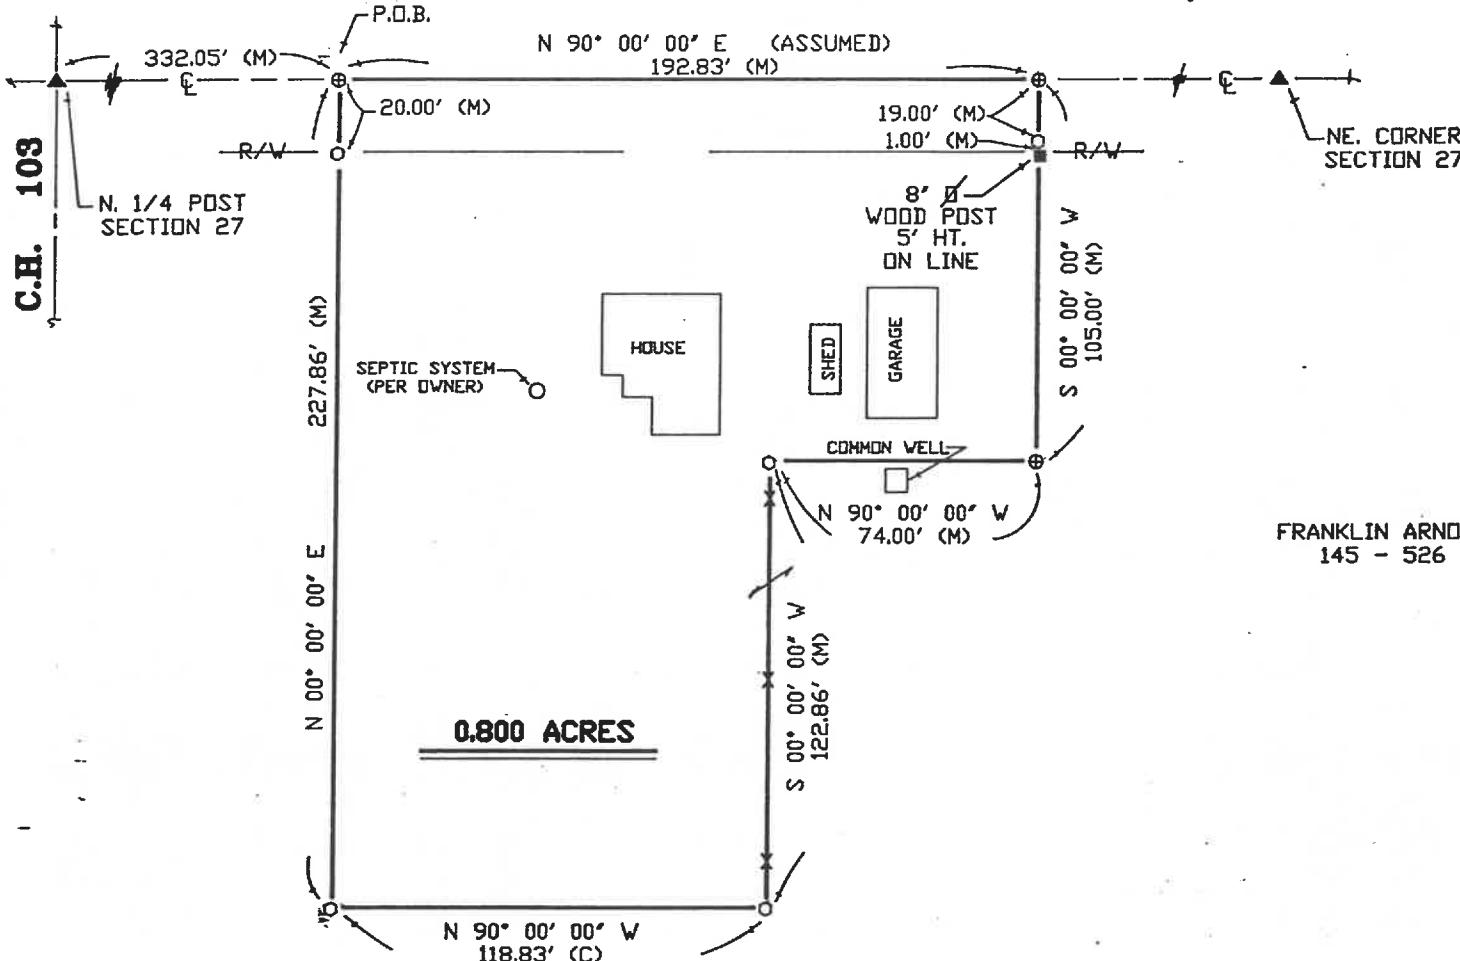

REFERENCES

DEED VOLUME & PAGE AS SHOWN
WYANDOT COUNTY CORNERSTONE REFERENCES
SURVEY NO. 616

NOTE: ALL IRON ROD SET ARE 1/2" DIA. WITH PERSONALIZED CAPS (HANK # 6972) DRIVEN FLUSH.

SURVEY NO. 7688 ✓
VOL 6 PAGE 605
DATE JULY 19, 1990

LEGEND

SET	FOUND	DESCRIPTION
△	▲	STONE
○	○	MONUMENT BOX
◎	◎	CONC. MONUMENT
●	●	RAILROAD SPIKE
■	■	NAIL
◆	◆	IRON ROD
○○	○○	IRON PIPE
○○○	○○○	DRILL HOLE
○○○○	○○○○	WOOD POST
◆◆	◆◆	DEED
◆◆◆	◆◆◆	PLAT
◆◆◆◆	◆◆◆◆	MEASURED
◆◆◆◆◆	◆◆◆◆◆	SURVEYED
◆◆◆◆◆◆	◆◆◆◆◆◆	CALCULATED

I HEREBY DECLARE THAT THE ABOVE PARCEL
WAS SURVEYED DURING JULY, 1990
PROPERTY LINES SHOWN ARE LOCATED FROM
DEEDS ON RECORD AND ARE DEED LINES.
BEARINGS ARE ASSUMED FOR ANGULAR MEA-
SUREMENT ONLY. ALL INFORMATION SHOWN IS
TRUE AND CORRECT TO THE BEST OF MY
KNOWLEDGE AND BELIEF.



James G. Homan, Jr., P.S. #6972 DATE
ORIGINAL SIGNED IN RED INK

HANK AND ASSOCIATES, INC.

ENGINEERING • SURVEYING
49 SOUTH WASHINGTON STREET, TIFFIN, OHIO 44883
419-447-4300

SURVEY FOR: **FRANK ARNOLD**

LOCATED IN THE NE. 1/4 OF SECTION 27,
MIFFLIN TOWNSHIP, T-3-S, R-13-E,
WYANDOT COUNTY, OHIO

DRAWN BY:	CHECKED BY:	SHEET NO.
JGN 7-16-90	JCH	1 1
REVISIONS		JOB NO.
		90072-S