


CAROLYN POOL, et al
181 - 1083



1' = 100' 100 0 100 200
SCALE FEET

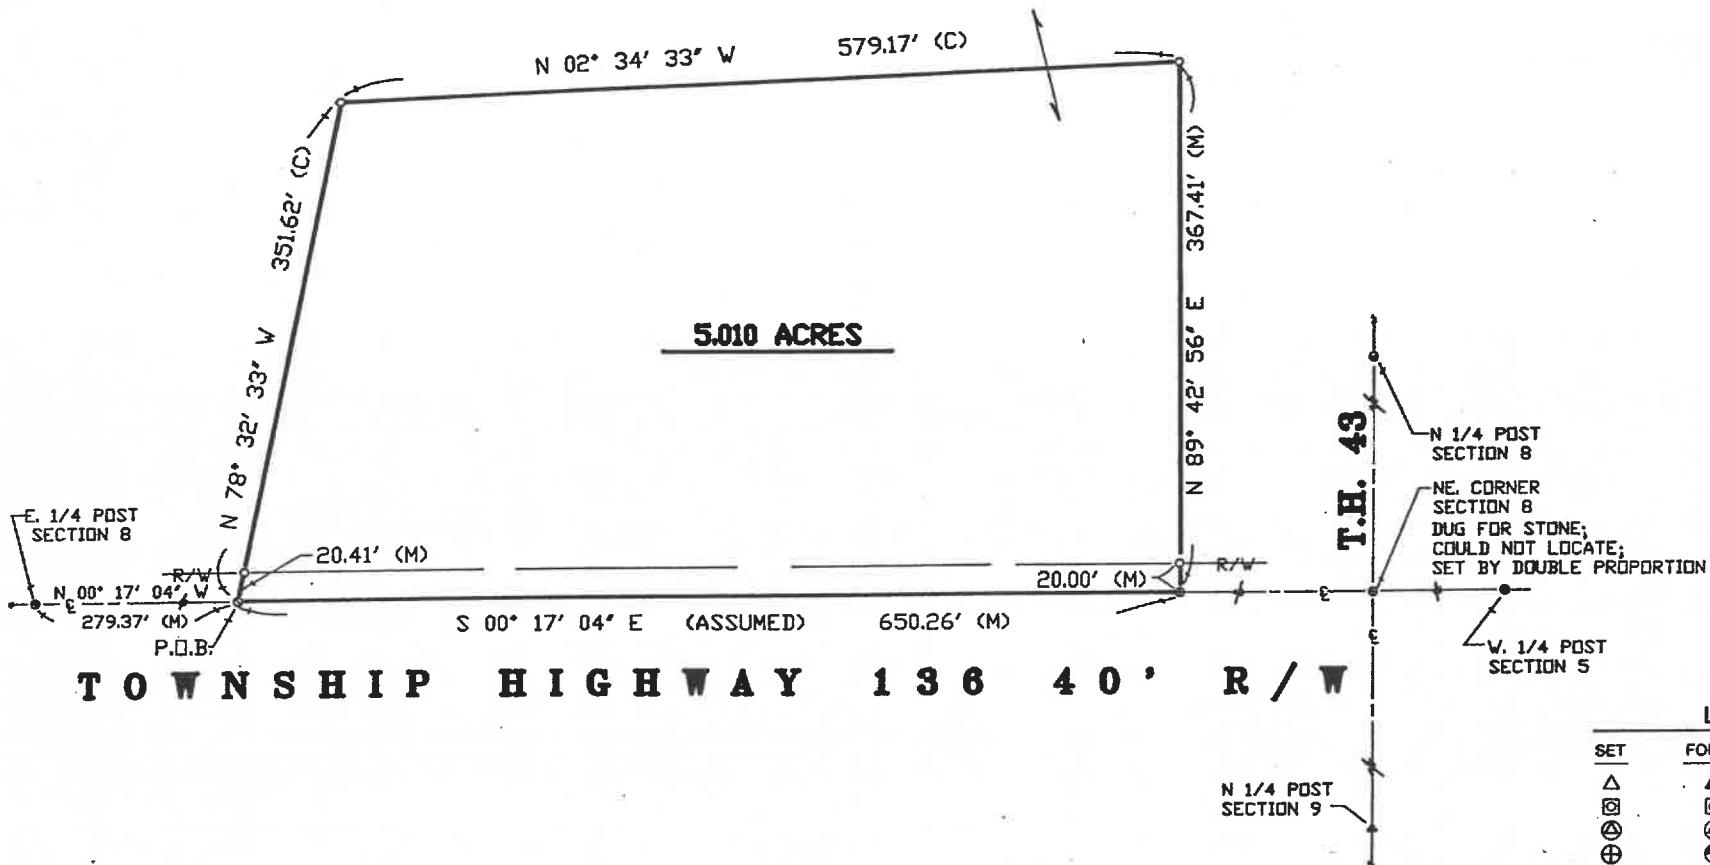

TOWNSHIP HIGHWAY 136 40' R / W

NOTE: ALL IRON ROD SET ARE 1/2" DIA. WITH PERSONALIZED CAPS (HANK # 6972) DRIVEN FLUSH.

SURVEY NO. 3692 ✓
VOL 6 PAGE 607
DATE AUG 27, 1990

LEGEND

SET	FOUND	DESCRIPTION
△	▲	STONE
□	■	MONUMENT BOX
○	○	CONC. MONUMENT
⊕	⊕	RAILROAD SPIKE
●	●	NAIL
○○	○○	IRON ROD
○○○	○○○	IRON PIPE
○○○○	○○○○	DRILL HOLE
○○○○○	○○○○○	WOOD POST
△	△	DEED
□	□	PLAT
M	M	MEASURED
S	S	SURVEYED
C	C	CALCULATED

I HEREBY DECLARE THAT THE ABOVE PARCEL
WAS SURVEYED DURING AUGUST, 1990.
PROPERTY LINES SHOWN ARE LOCATED FROM
DEEDS ON RECORD AND ARE DEED LINES.
BEARINGS ARE ASSUMED FOR ANGULAR MEA-
SUREMENT ONLY. ALL INFORMATION SHOWN IS
TRUE AND CORRECT TO THE BEST OF MY
KNOWLEDGE AND BELIEF.



James G. Homan, Jr., P.S. #6972 DATE
ORIGINAL SIGNED IN RED INK

HANK AND ASSOCIATES, INC.
ENGINEERING • SURVEYING
49 SOUTH WASHINGTON STREET, TIFFIN, OHIO 44883
419-447-4300

SURVEY FOR: CAROLYN POOL

LOCATED IN THE NE. 1/4 OF SECTION 8,
EDEN TOWNSHIP, T-2-S, R-15-E,
WYANDOT COUNTY, OHIO

DRAWN BY:	CHECKED BY:	SHEET NO.
BIN 8-25-90	JGH 8-25-90	1 / 1
REVISIONS		JOB NO.
30060-S (287)		