


SURVEY NO. 3713
VOL. 6 PAGE 685
DATE Nov 9, 1990

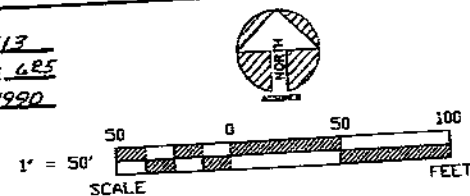

REFERENCES

DEED VOLUME & PAGE AS SHOWN
WYANDOT COUNTY CORNERSTONE REFERENCES
S.W. SEC. 'J', DATED 1932

NOTE: C. S.R. 37 IS NOT THE
N-S 1/4 SECTION LINE. R/V
NOT KNOWN. 60' OCCUPIED
70' SHOWN ON PLANS

ROBERT RICKENBACHER
152 - 565

NOTE: ALL IRON ROD SET ARE 1/2" DIA. WITH
PERSONALIZED CAPS (HANK # 6972)
DRIVEN FLUSH.


LEGEND

SET	FOUND	DESCRIPTION
▲	▲	STONE
■	■	MONUMENT BOX
⊙	⊙	CONG. MONUMENT
⊗	⊗	RAILROAD SPIKE
●	●	NAIL
○	○	IRON ROD
⊖	⊖	IRON PIPE
⊕	⊕	DRILL HOLE
⊗	⊗	WOOD POST
⊙	⊙	DEED
⊖	⊖	PLAT
⊕	⊕	MEASURED
⊗	⊗	SURVEYED
⊙	⊙	CALCULATED

I HEREBY DECLARE THAT THE ABOVE PARCEL
WAS SURVEYED DURING OCT 1990
PROPERTY LINES SHOWN ARE LOCATED FROM
DEEDS ON RECORD AND ARE DEED LINES
BEARINGS ARE ASSUMED FOR ANGULAR MEA-
SUREMENT ONLY ALL INFORMATION SHOWN IS
TRUE AND CORRECT TO THE BEST OF MY
KNOWLEDGE AND BELIEF



James G. Norman, Jr.
JAMES G. NORMAN, JR., P.S. #6972 DATE
ORIGINAL SIGNED BY RED INK

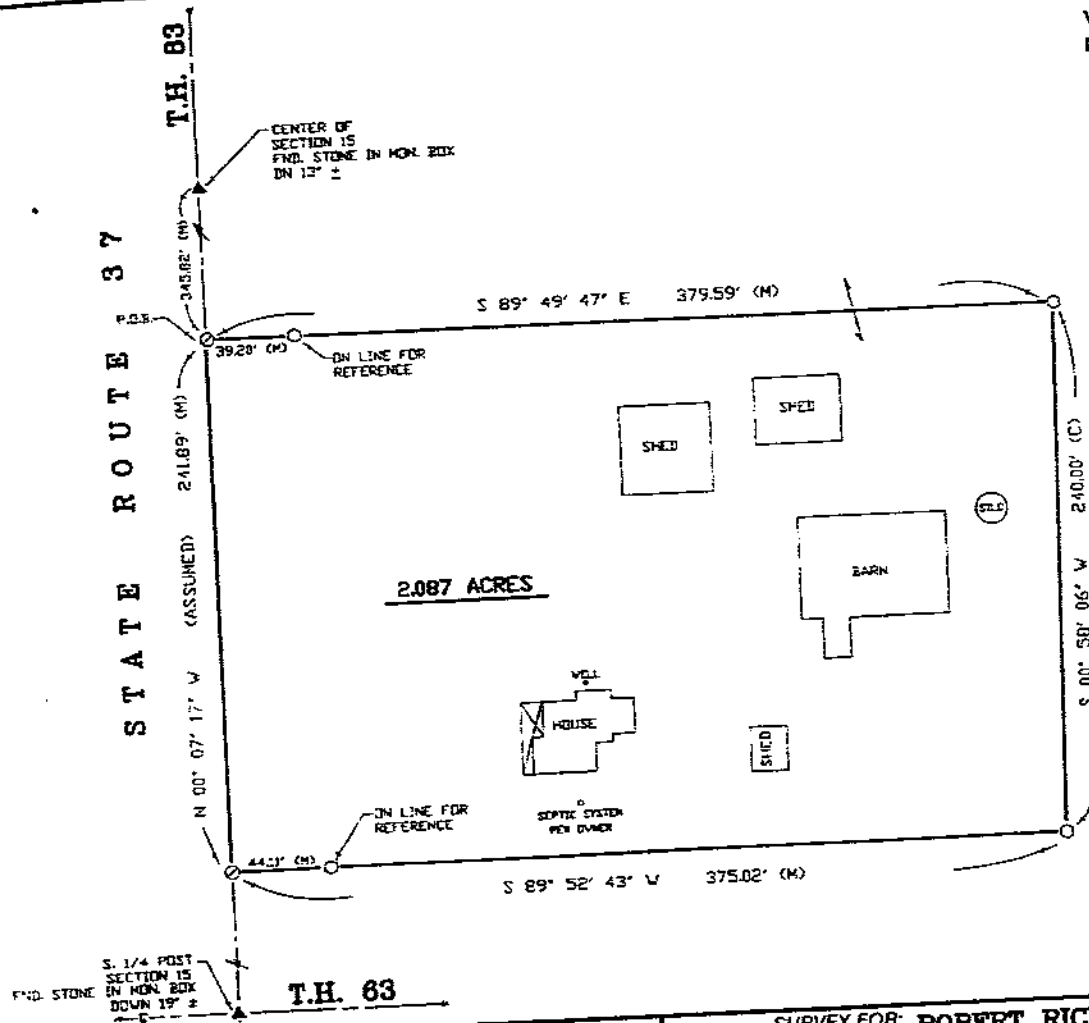

HANK AND ASSOCIATES, INC.

ENGINEERING • SURVEYING
49 SOUTH WASHINGTON STREET, TIFFIN, OHIO 44883
419-447-4300

SURVEY FOR: **ROBERT RICKENBACHER**

LOCATED IN THE SE. 1/4 OF SECTION 15,
JACKSON TOWNSHIP, T-3-S, R-12-E,
WYANDOT COUNTY, OHIO

DRAWN BY:	CHECKED BY:	SHEET NO.
dja 10-29-90	Jed 11-03-90	1
REVISIONS		JOB NO.
		90130-5
		(497)