
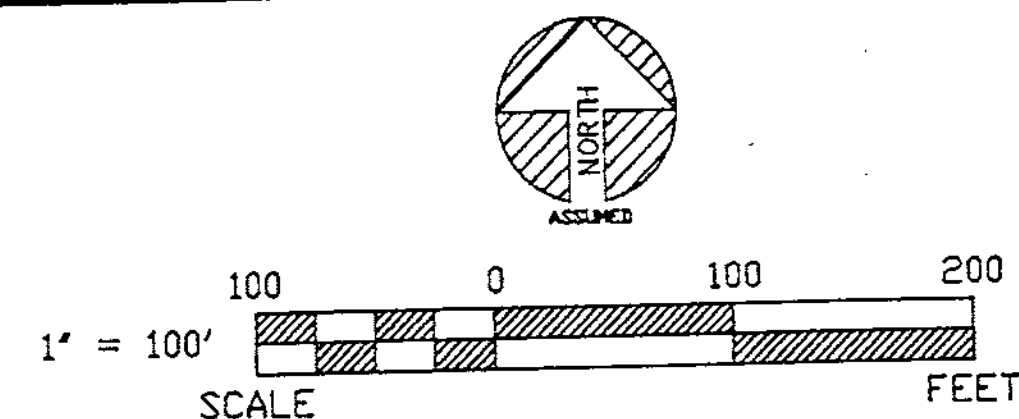


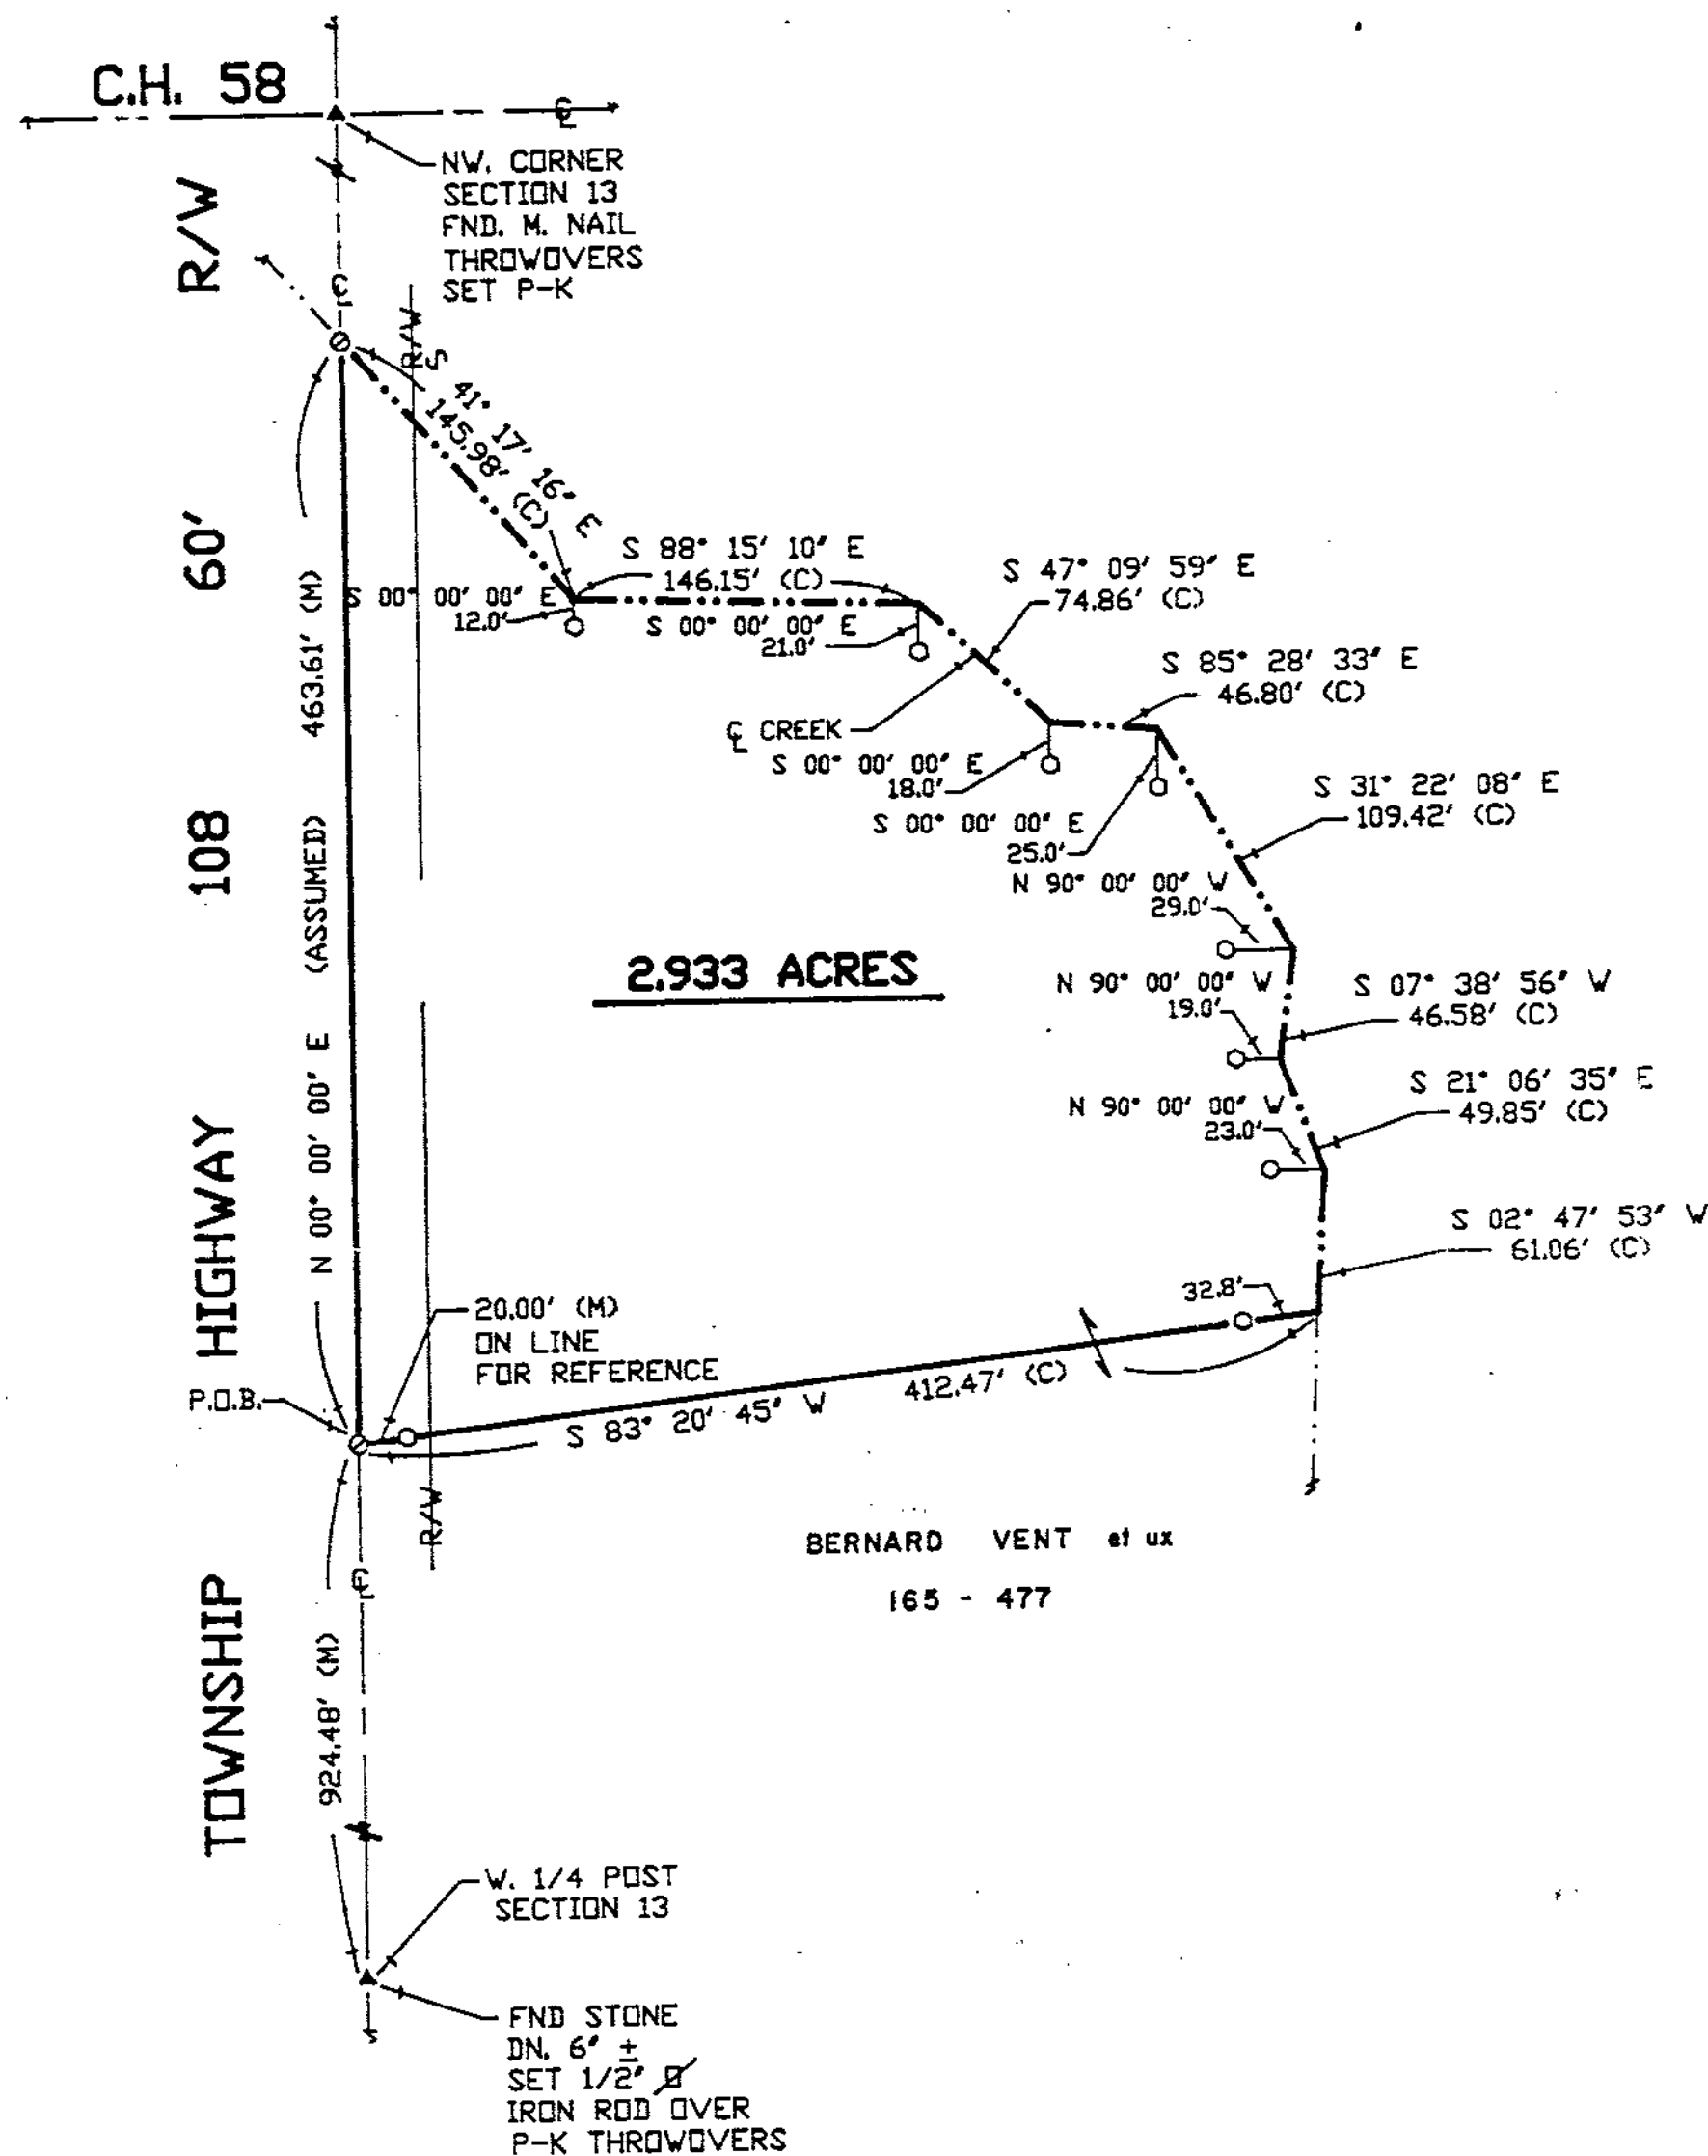

REFERENCES

DEED VOLUME & PAGE AS SHOWN

WYANDOT COUNTY CORNERSTONE REFERENCES

SURVEY VOLUME & PAGE:

VOL. 2, PG. 209

SURVEY NO. 3728

VOL. 7 PAGE 133

DATE 12-24-90

NOTE: ALL IRON ROD SET ARE 1/2" DIA. WITH PERSONALIZED CAPS (HANK # 6972) DRIVEN FLUSH.

LEGEND

SET	FOUND	DESCRIPTION
△	▲	STONE
□	■	MONUMENT BOX
⊕	⊕	CONC. MONUMENT
⊗	⊗	RAILROAD SPIKE
⊙	⊙	NAIL
○	●	IRON ROD
○	●	IRON PIPE
○	●	DRILL HOLE
○	■	WOOD POST
D		DEED
P		PLAT
M		MEASURED
S		SURVEYED
C		CALCULATED

I HEREBY DECLARE THAT THE ABOVE PARCEL WAS SURVEYED DURING DECEMBER, 1990. PROPERTY LINES SHOWN ARE LOCATED FROM DEEDS ON RECORD AND ARE DEED LINES. BEARINGS ARE ASSUMED FOR ANGULAR MEASUREMENT ONLY. ALL INFORMATION SHOWN IS TRUE AND CORRECT TO THE BEST OF MY KNOWLEDGE AND BELIEF.



James G. Homan, Jr.
JAMES G. HOMAN, JR., P.S. #6972 DATE 12-19-90
ORIGINAL SIGNED IN RED INK

HANK AND ASSOCIATES, INC.

ENGINEERING • SURVEYING
49 SOUTH WASHINGTON STREET, TIFFIN, OHIO 44883
419-447-4300

SURVEY FOR: **LAURI VENT**

LOCATED IN THE NW. 1/4 OF SECTION 13,
MIFFLIN TOWNSHIP, T-3-S, R-13-E,
WYANDOT COUNTY, OHIO

DRAWN BY:	CHECKED BY:	SHEET NO.
DJN 12-14-90	AGH 12-19-90	1 / 1
REVISIONS		JOB NO.
		90154-S CSSD