
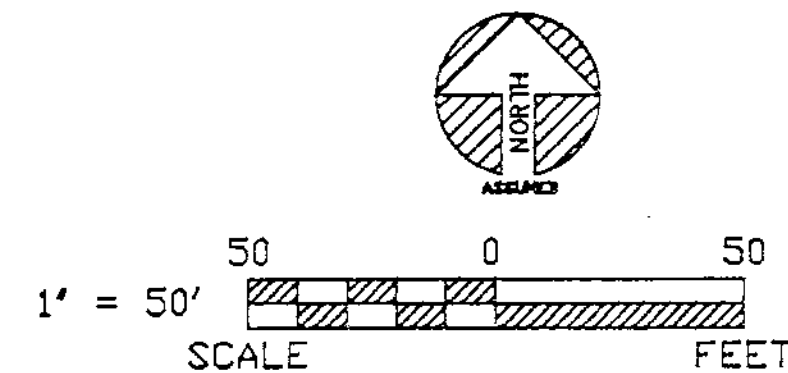


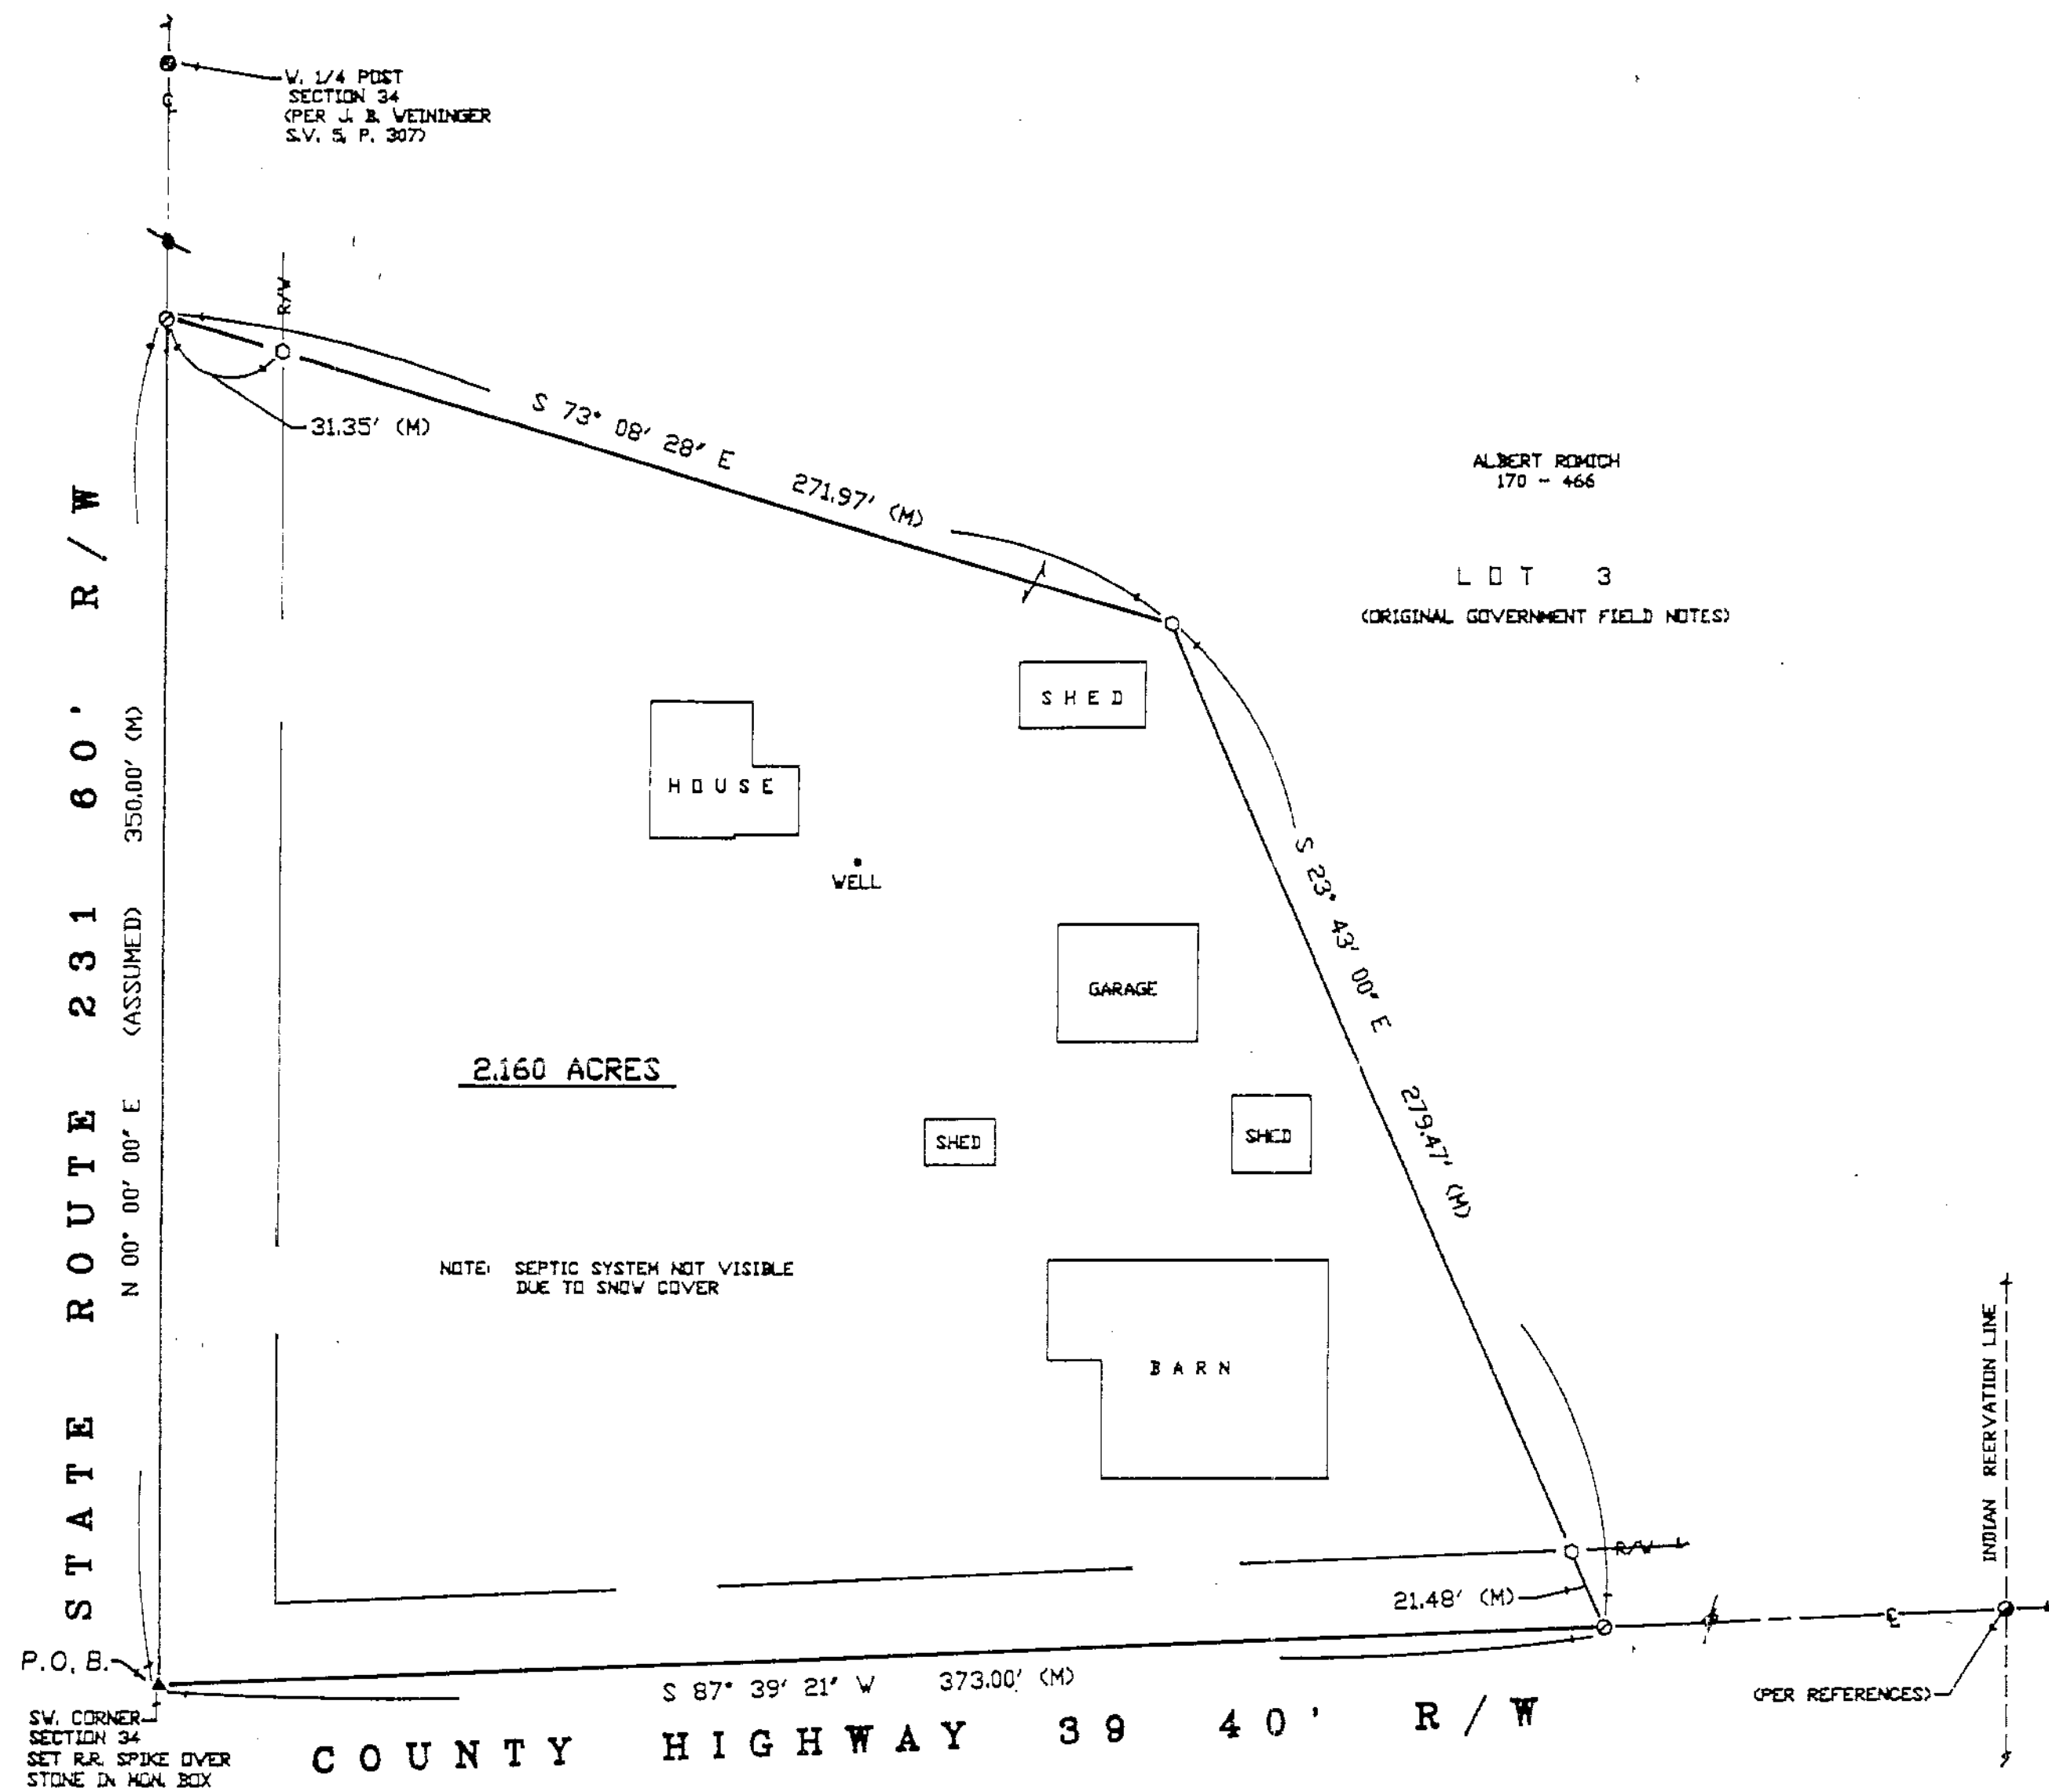

REFERENCES

DEED VOLUME & PAGE AS SHOWN

WYANDOT COUNTY CORNERSTONE REFERENCES

SURVEY VOLUME & PAGE

VOL. 3, PG. 275
VOL. 3, PG. 307

ORIGINAL GOVERNMENT FIELD NOTES

SURVEY NO. 9108

VOL. 7 PAGE 143


DATE FEB. 7, 1991

NOTE: ALL IRON ROD SET ARE 1/2" DIA. WITH
PERSONALIZED CAPS (HANK # 6972)
DRIVEN FLUSH.

LEGEND

SET	FOUND	DESCRIPTION
△	▲	STONE
□	■	MONUMENT BOX
⊙	⊙	CONC. MONUMENT
⊕	⊕	RAILROAD SPIKE
⊗	⊗	NAIL
⊘	⊘	IRON ROD
⊙	⊙	IRON PIPE
⊙	⊙	DRILL HOLE
⊙	⊙	WOOD POST
D		DEED
P		PLAT
M		MEASURED
S		SURVEYED
C		CALCULATED

I HEREBY DECLARE THAT THE ABOVE PARCEL
WAS SURVEYED DURING JANUARY, 1991
PROPERTY LINES SHOWN ARE LOCATED FROM
DEEDS ON RECORD AND ARE DEED LINES.
BEARINGS ARE ASSUMED FOR ANGULAR MEA-
SUREMENT ONLY. ALL INFORMATION SHOWN IS
TRUE AND CORRECT TO THE BEST OF MY
KNOWLEDGE AND BELIEF.

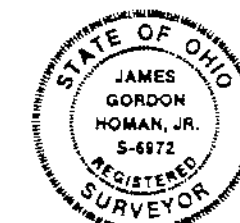

James G. Homan, Jr.
JAMES G. HOMAN, JR., R.S. #6972 DATE
ORIGINAL SIGNED IN RED INK

HANK AND ASSOCIATES, INC.

ENGINEERING

SURVEYING

137 SOUTH WASHINGTON STREET, TIFFIN, OHIO 44883
419-447-4300

SURVEY FOR:

ALBERT ROMICH

LOCATED IN PART OF LOT 3 IN THE SW. 1/4 OF
SECTION 34, SYCAMORE TOWNSHIP, T-1-S, R-15-E,
WYANDOT COUNTY, OHIO

DRAWN BY:

DJN 01-31-91

CHECKED BY:

JGH 02-02-91

SHEET NO.

1 / 1

REVISIONS

JOB NO.

91007-S
(39)