

50 0 50
1' = 50' SCALE FEET


REFERENCES

DEED VOLUME & PAGE AS SHOWN

WYANDOT COUNTY CORNERSTONE REFERENCES

SURVEY NO. 9163
VOL. 7 PAGE 192
DATE OCT 24, 1991

NOTE: ALL IRON ROD SET ARE 1/2" DIA. WITH PERSONALIZED CAPS (HANK # 6972) DRIVEN FLUSH.

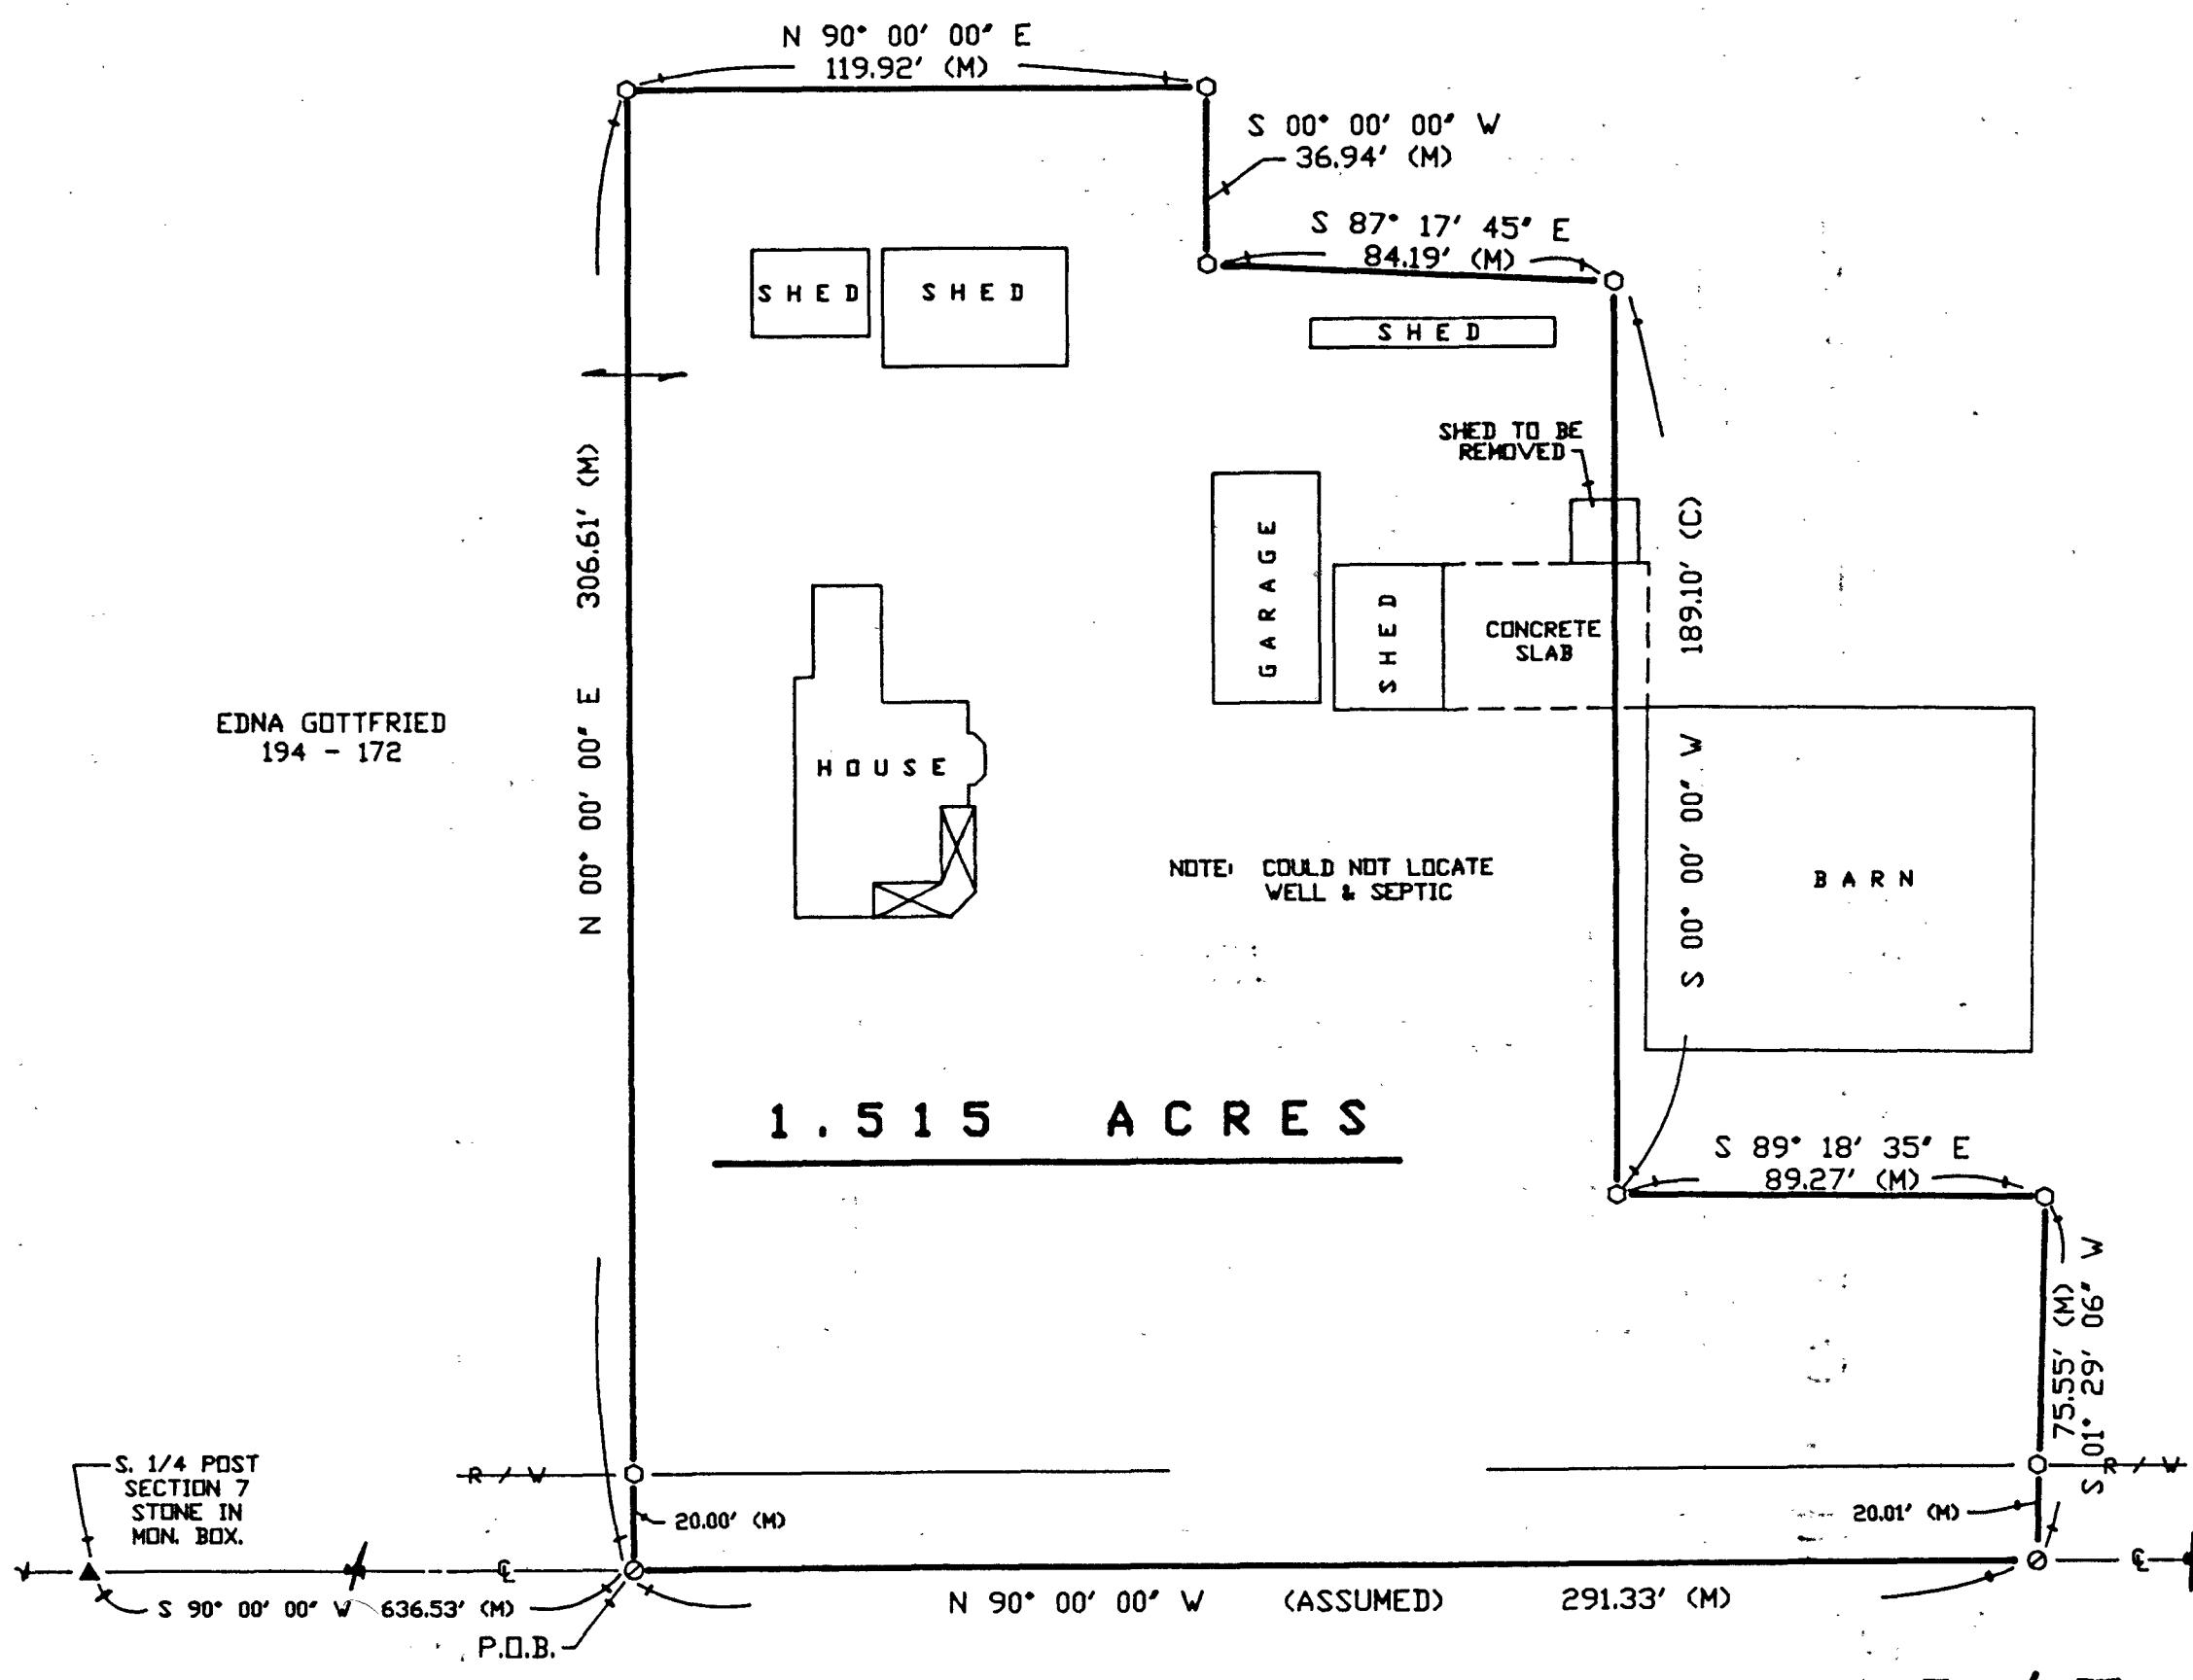

T.H. 112

LEGEND

SET	FOUND	DESCRIPTION
△	▲	STONE
□	□	MONUMENT BOX
○	○	CONC. MONUMENT
⊕	⊕	RAILROAD SPIKE
●	●	NAIL
◆	◆	IRON ROD
●	●	IRON PIPE
○	○	DRILL HOLE
■	■	WOOD POST
D	D	DEED
P	P	PLAT
M	M	MEASURED
S	S	SURVEYED
C	C	CALCULATED

I HEREBY DECLARE THAT THE ABOVE PARCEL
WAS SURVEYED DURING SEPT. 1991
PROPERTY LINES SHOWN ARE LOCATED FROM
DEEDS ON RECORD AND ARE DEED LINES.
BEARINGS ARE ASSUMED FOR ANGULAR MEA-
SUREMENT ONLY. ALL INFORMATION SHOWN IS
TRUE AND CORRECT TO THE BEST OF MY
KNOWLEDGE AND BELIEF.



James G. Homan, Jr., P.S. #6972 DATE
JAMES G. HOMAN, JR., P.S. #6972 DATE
ORIGINAL SIGNED IN RED INK

HANK AND ASSOCIATES, INC.
ENGINEERING • SURVEYING
137 SOUTH WASHINGTON STREET, TIFFIN, OHIO 44883
419-447-4300

SURVEY FOR: **LUTHER GOTTFRIED**

LOCATED IN THE SE. 1/4 OF SECTION 7,
CRANE TOWNSHIP, T-2-S, R-14-E,
WYANDOT COUNTY, OHIO

DRAWN BY:	CHECKED BY:	SHEET NO.
D.J.N. 9-91	J.G.H. 10-14-91	1 1
REVISIONS		
JOB NO.		

91094-S
(388)