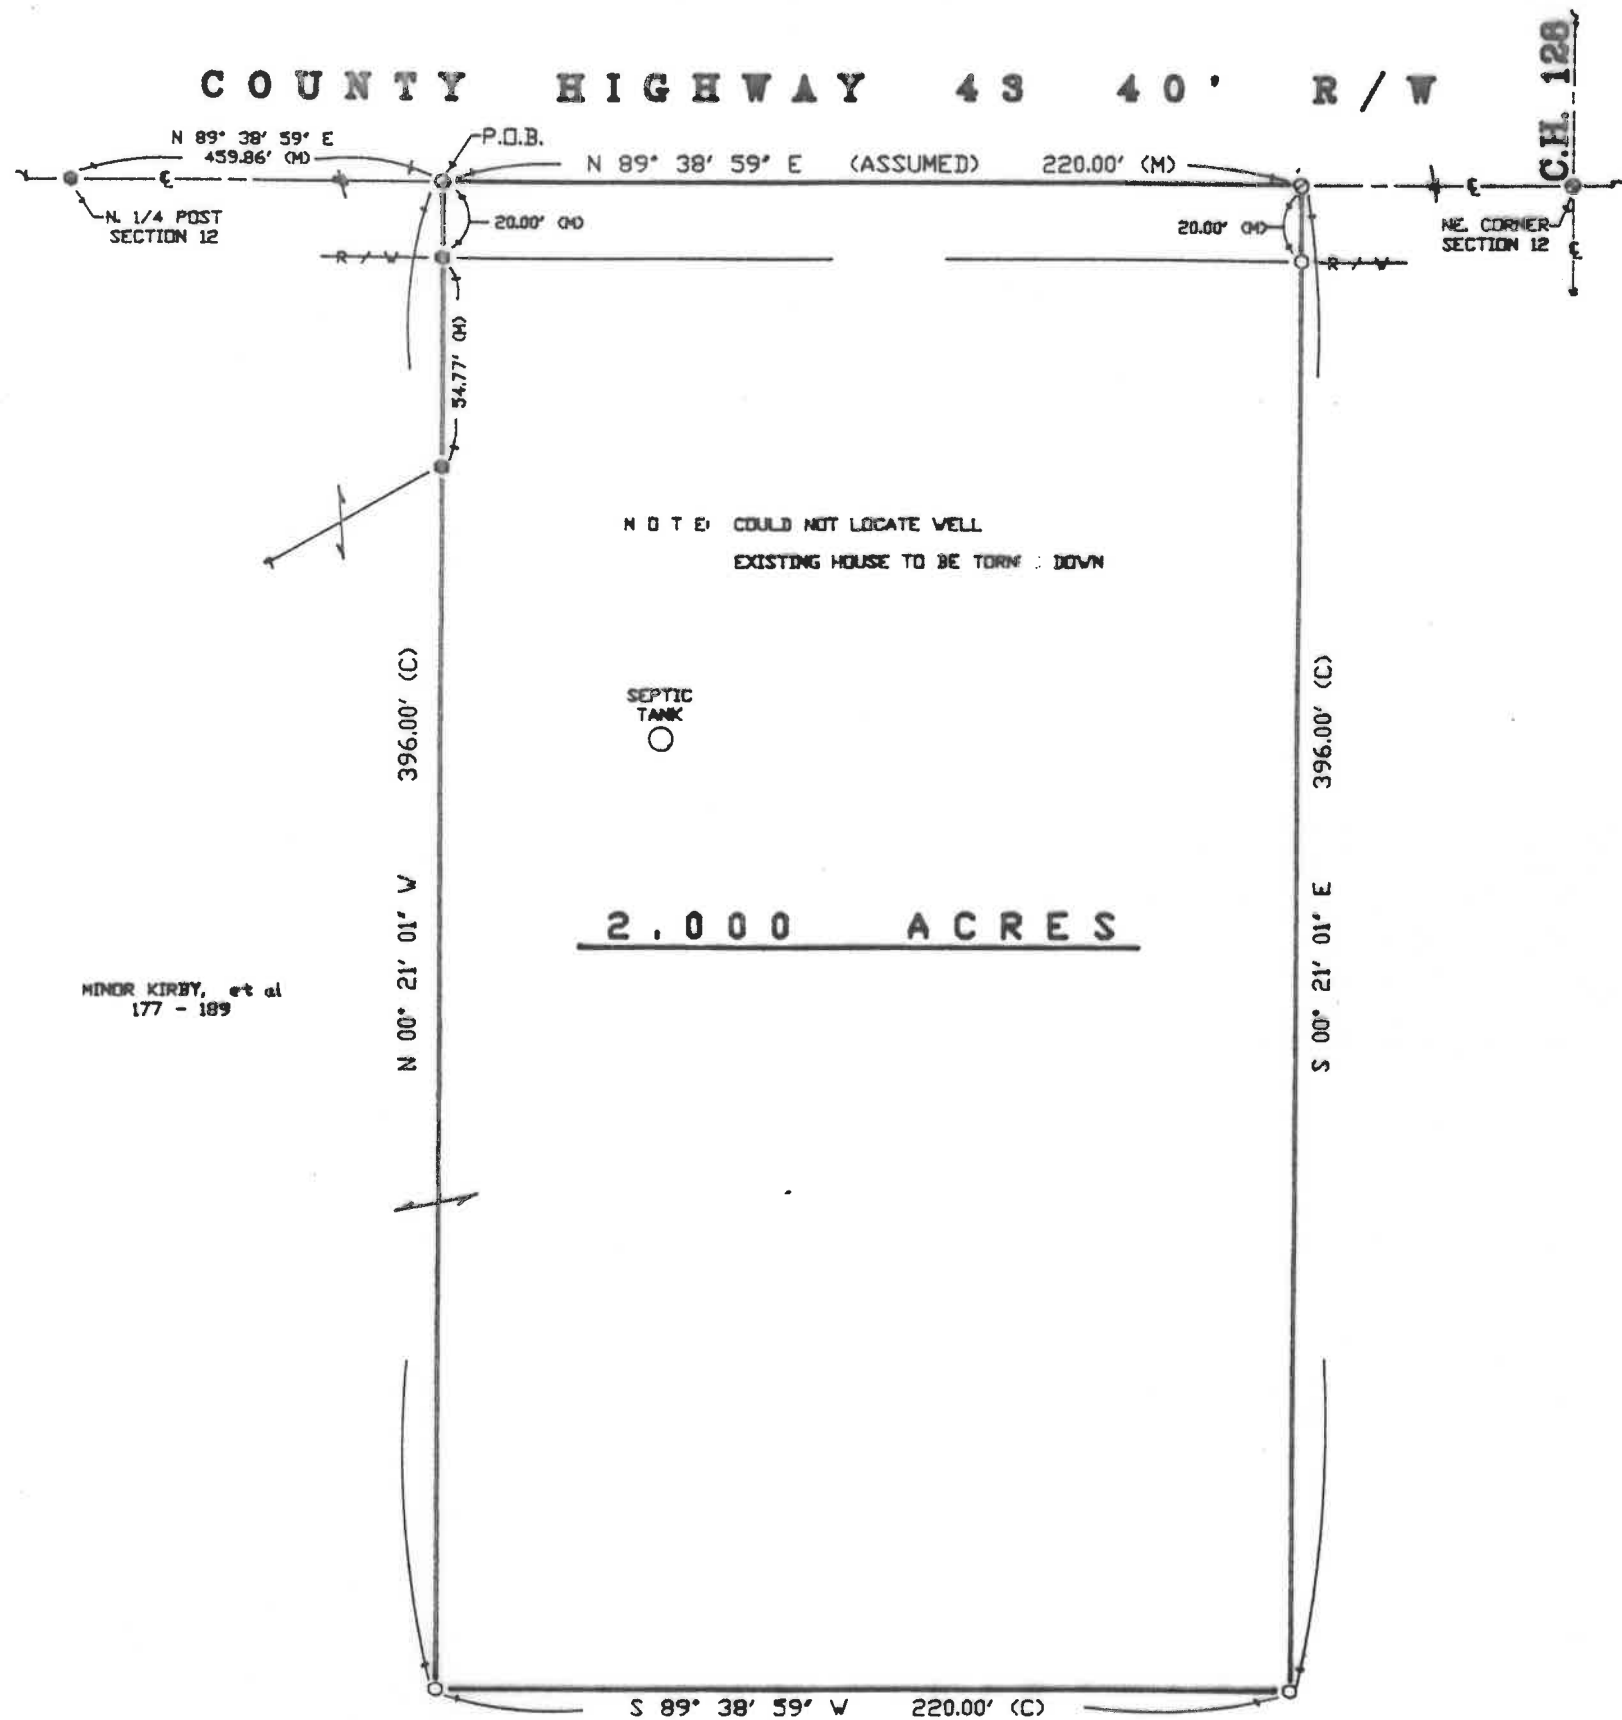


REFERENCES

DEED VOLUME & PAGE AS SHOWN
SURVEY VOLUME 7, PAGE 124

SURVEY NO. 9170
VOL 8 PAGE 3
DATE Nov 13, 1991

NOTE: ALL IRON ROD SET ARE 1/2" DIA. WITH PERSONALIZED CAPS (HANK # 6972) DRIVEN FLUSH.

LEGEND

SET	FOUND	DESCRIPTION
△	▲	STONE
⊠	■	MONUMENT BOX
⊙	●	CONC. MONUMENT
⊕	⦿	RAILROAD SPIKE
⊗	⦿	NAIL
○	●	IRON ROD
○	●	IRON PIPE
○	●	DRILL HOLE
○	■	WOOD POST
	D	DEED
	P	PLAT
	M	MEASURED
	S	SURVEYED
	C	CALCULATED

I HEREBY DECLARE THAT THE ABOVE PARCEL WAS SURVEYED DURING NOVEMBER, 1991.
PROPERTY LINES SHOWN ARE LOCATED FROM DEEDS ON RECORD AND ARE DEED LINES. BEARINGS ARE ASSUMED FOR ANGULAR MEASUREMENT ONLY. ALL INFORMATION SHOWN IS TRUE AND CORRECT TO THE BEST OF MY KNOWLEDGE AND BELIEF.



James G. Homan, Jr.
JAMES G. HOMAN, JR., P.S. #6972 DATE 11-11-91
ORIGINAL SIGNED IN RED INK

HANK AND ASSOCIATES, INC.

ENGINEERING • SURVEYING
137 SOUTH WASHINGTON STREET, TIFFIN, OHIO 44883
419-447-4300

SURVEY FOR: **RICHARD MOLER**

LOCATED IN THE NE. 1/4 OF SECTION 12,
EDEN TOWNSHIP, T-2-S, R-14-E,
WYANDOT COUNTY, OHIO

DRAWN BY:	CHECKED BY:	SHEET NO.
DJM 11-91	JGH 11-11-91	1 / 1
REVISIONS		JOB NO.
		91021-S (99)