

13

REFERENCES

DEED VOLUME & PAGE AS SHOWN


WYANDOT COUNTY CORNERSTONE REFERENCES

SURVEY NO. 9/83

VOL 8 PAGE 13

DATE DEC. 18, 1991

NOTE: ALL IRON ROD SET ARE 1/2" DIA. WITH PERSONALIZED CAPS (HANK # 6972) DRIVEN FLUSH

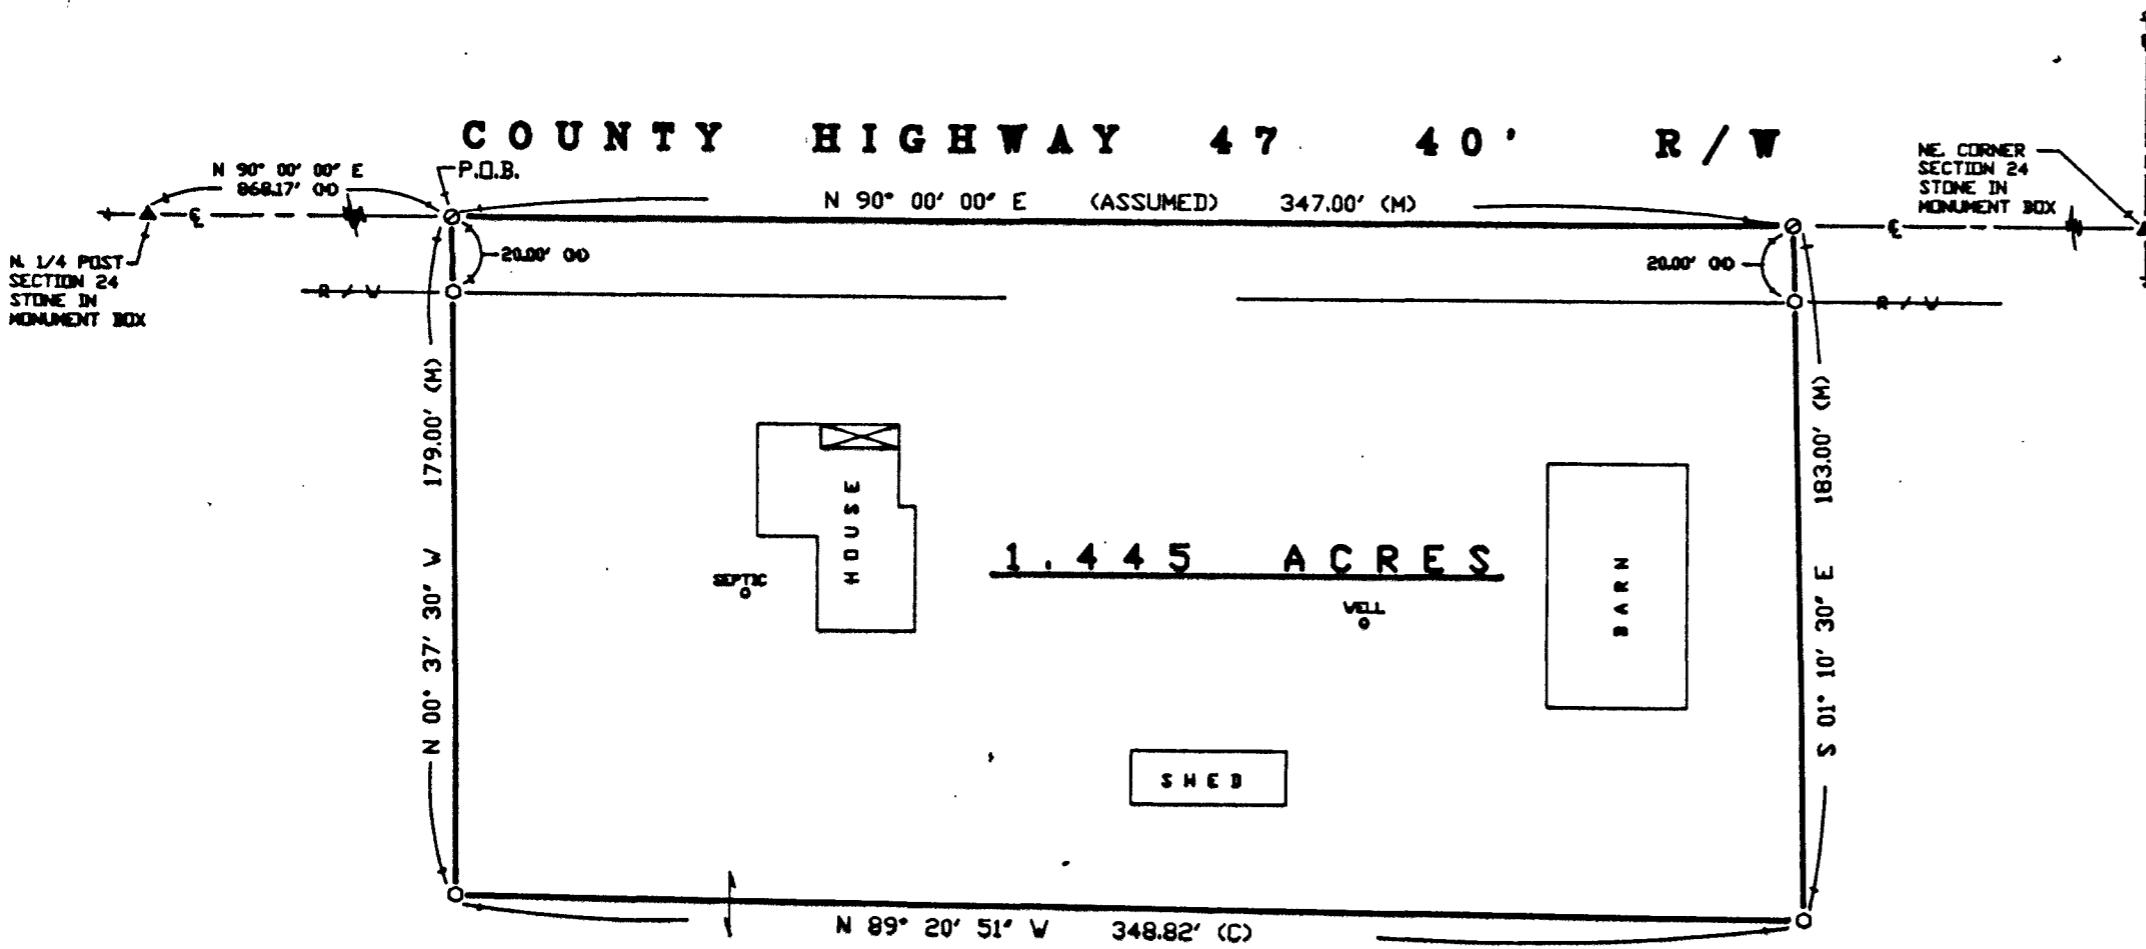

LEGEND

SET	FOUND	DESCRIPTION
△	▲	STONE
□	□	MONUMENT BOX
◎	◎	CONC. MONUMENT
⊕	⊕	RAILROAD SPIKE
○	○	NAIL
○	○	IRON ROD
○	○	IRON PIPE
○	○	DRILL HOLE
○	○	WOOD POST
○	○	DEED
○	○	PLAT
○	○	MEASURED
○	○	SURVEYED
○	○	CALCULATED

I HEREBY DECLARE THAT THE ABOVE PARCEL
WAS SURVEYED DURING DECEMBER, 1991
PROPERTY LINES SHOWN ARE LOCATED FROM
DEEDS ON RECORD AND ARE DEED LINES.
BEARINGS A.F. ASSUMED FOR ANGULAR MEA-
SUREMENT ONLY. ALL INFORMATION SHOWN IS
TRUE AND CORRECT TO THE BEST OF MY
KNOWLEDGE AND BELIEF.



James G. Homan Jr. R. 12-12-91
JAMES G. HOMAN, JR., P.S. #6972 DATE

G. HUMAN, JR., F.S. #6372
ORIGINAL SIGNED IN RED INK

ORIGINAL SIGNED IN RED INK

HANK AND ASSOCIATES, INC.

SURVEY FOR: DONOLD PLOTTS

LOCATED IN THE NE. 1/4 OF SECTION 24,
RICHLAND TOWNSHIP, T-2-S, R-12-E,
WYANDOT COUNTY, OHIO

DRAWN BY:	CHECKED BY:	SHEET NO.
DJM 12-91	JCH 12-13-91	1 / 1
REVISIONS		JOB NO.
		91144-S (598)