
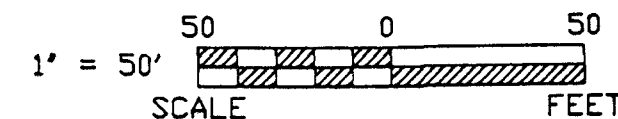


MARK ROMICH
D.V. 197, PG. 845, 847

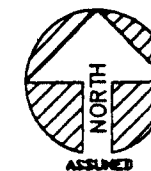

REFERENCES

DEED VOLUME & PAGE AS SHOWN

WYANDOT COUNTY CORNERSTONE REFERENCES

SURVEY NO. 9208

VOL 8 PAGE 25

DATE JAN. 29, 1992

NOTE: ALL IRON ROD SET ARE 1/2" DIA. WITH
PERSONALIZED CAPS (HANK # 6972)
DRIVEN FLUSH.

LEGEND

SET	FOUND	DESCRIPTION
△	▲	STONE
⊠	⊠	MONUMENT BOX
⊙	⊙	CONC. MONUMENT
⊕	⊕	RAILROAD SPIKE
⊗	⊗	NAIL
○	●	IRON ROD
○	●	IRON PIPE
○	●	DRILL HOLE
○	■	WOOD POST
	D	DEED
	P	PLAT
	M	MEASURED
	S	SURVEYED
	C	CALCULATED

I HEREBY DECLARE THAT THE ABOVE PARCEL
WAS SURVEYED DURING JANUARY, 1992
PROPERTY LINES SHOWN ARE LOCATED FROM
DEEDS ON RECORD AND ARE DEED LINES.
BEARINGS ARE ASSUMED FOR ANGULAR MEASUREMENT ONLY. ALL INFORMATION SHOWN IS
TRUE AND CORRECT TO THE BEST OF MY
KNOWLEDGE AND BELIEF.



James G. Homan, Jr.
JAMES G. HOMAN, JR., P.S. #6972 DATE
ORIGINAL SIGNED IN RED INK

HANK AND ASSOCIATES, INC.

ENGINEERING

SURVEYING

137 SOUTH WASHINGTON STREET, TIFFIN, OHIO 44883
419-447-4300

SURVEY FOR: **MARK ROMICH**

LOCATED IN THE NW. 1/4 OF SECTION 3,
EDEN TOWNSHIP, T-2-S, R-15-E,
WYANDOT COUNTY, OHIO

DRAWN BY:

DJN 1-92

CHECKED BY:

JCH 01-28-92

SHEET NO.

1 / 1

REVISIONS

JOB NO.

91165-S
(77)