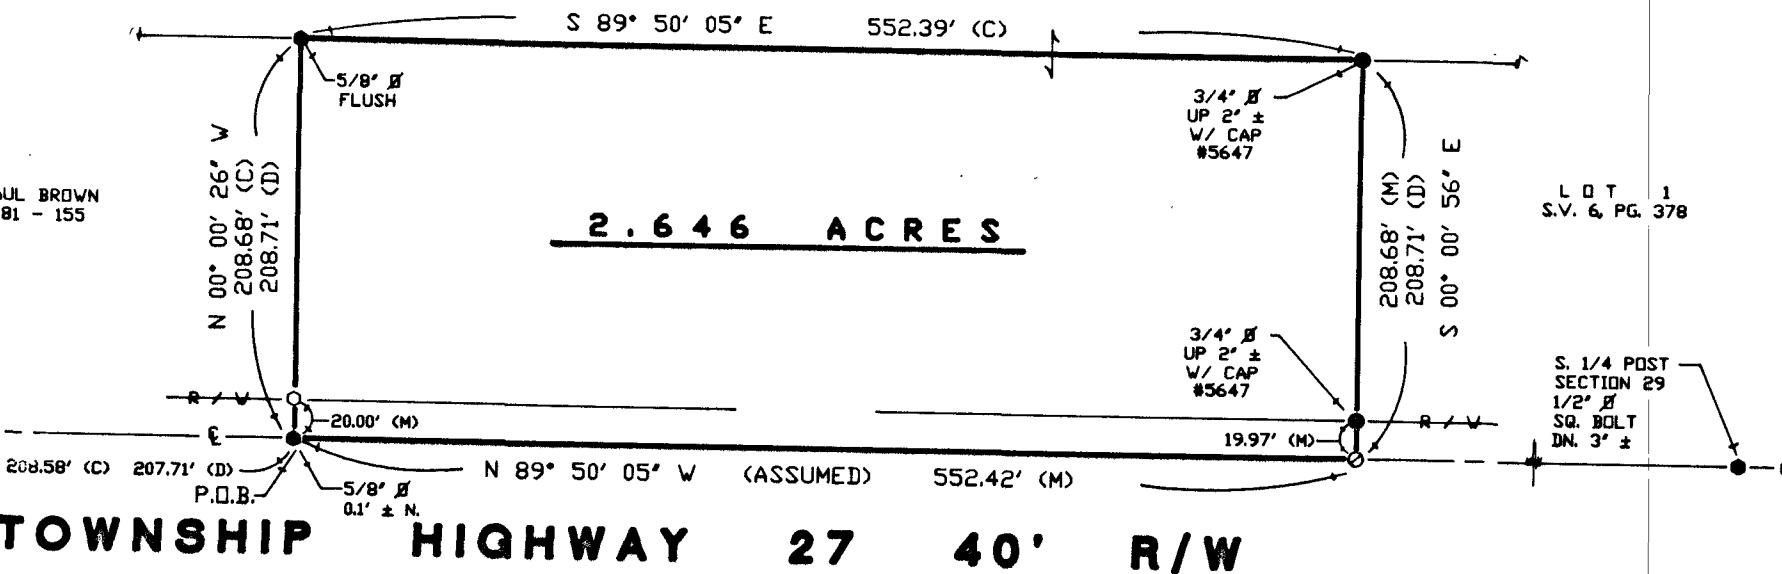



## COUNTRY HIGHWAY 8

PAUL BROWN  
181 - 155

49

1' = 100' FEET

SCALE

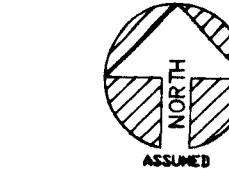

## REFERENCES

DEED VOLUME &amp; PAGE AS SHOWN

WYANDOT COUNTY CORNERSTONE REFERENCES

SURVEY VOLUME 6, PAGE 116

SURVEY VOLUME 6, PAGE 378

SURVEY NO. 9244VOL 8 PAGE 49DATE MAY 29, 1992

NOTE: ALL IRON ROD SET ARE 1/2" DIA. WITH PERSONALIZED CAPS (HANK # 6972) DRIVEN FLUSH.

## LEGEND

SET	FOUND	DESCRIPTION
△	▲	STONE
□	■	MONUMENT BOX
△	●	CONC. MONUMENT
⊕	●	RAILROAD SPIKE
○	●	NAIL
○	●	IRON ROD
○	●	IRON PIPE
○	●	DRILL HOLE
○	●	WOOD POST
○	●	DEED
D	●	PLAT
P	●	MEASURED
M	●	SURVEYED
S	●	CALCULATED
C		

I HEREBY DECLARE THAT THE ABOVE PARCEL  
WAS SURVEYED DURING MAY, 1992PROPERTY LINES SHOWN ARE LOCATED FROM  
DEEDS ON RECORD AND ARE DEED LINES  
BEARINGS ARE ASSUMED FOR ANGULAR MEA-  
SUREMENT ONLY ALL INFORMATION SHOWN IS  
TRUE AND CORRECT TO THE BEST OF MY  
KNOWLEDGE AND BELIEF

*James G. Homan Jr.* P.S. #6972 DATE  
ORIGINAL SIGNED IN RED INK

**HANK AND ASSOCIATES, INC.**  
ENGINEERING • SURVEYING  
111 SOUTH WASHINGTON STREET, TIFFIN, OHIO 44883  
419-447-4300

SURVEY FOR: **PAUL BROWN**LOCATED IN THE SW. 1/4 OF SECTION 29,  
CRAWFORD TOWNSHIP, T-1-S, R-13-E,  
WYANDOT COUNTY, OHIO

DRAWN BY:	CHECKED BY:	SHEET NO.
DJN 5-92	JCH 6-13-92	1 / 1
REVISIONS		JOB NO.
92047-S (371)		