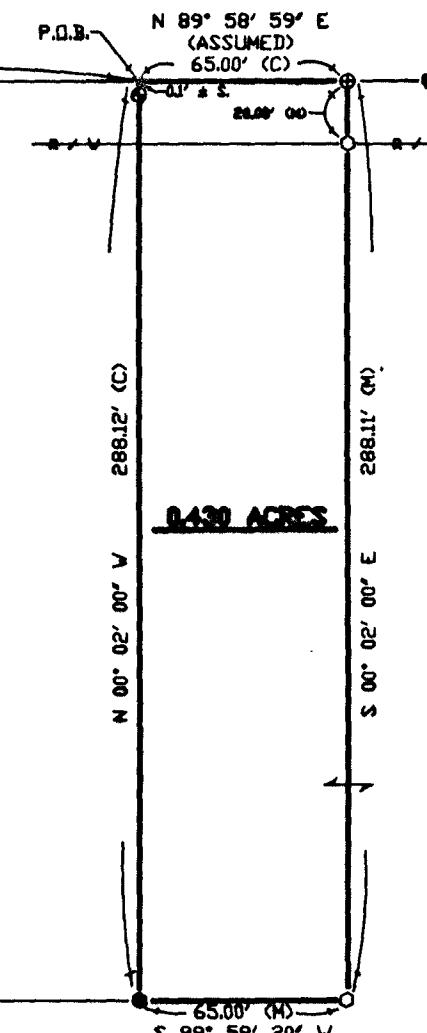


60

COUNTRY HIGHWAY

TOWNSHIP HIGHWAY 59 40' R/W

N 89° 58' 59" E 410.96' (C) 411.00' (D)

FND. STONE
IN MON. BOX

JEFFREY & BARBARA MCCLAIN
136 - 393
2.657 ACRES
S.V. 6, PG. 316

JOEL CASTANEN
137 - 400

1' = 60' 60 0 60
SCALE FEET



51

REFERENCES

DEED VOLUME & PAGE AS SHOWN

WYANDOT COUNTY CORNERSTONE REFERENCES

SURVEY VOLUME 6, PAGE 316

SURVEY NO. 9846
VOL B PAGE 51
DATE MAY 29, 1992

NOTE: ALL IRON ROD SET ARE 1/2" DIA. WITH
PERSONALIZED CAPS (HANK # 6972)
DRIVEN FLUSH.

LEGEND

SET	FOUND	DESCRIPTION
△	▲	STONE
□	□	MONUMENT BOX
◎	◎	CONC. MONUMENT
⊕	⊕	RAILROAD SPIKE
⊖	⊖	NAIL
○	○	IRON ROD
●	●	IRON PIPE
◆	◆	DRILL HOLE
◆◆	◆◆	WOOD POST
D	D	DEED
P	P	PLAT
M	M	MEASURED
S	S	SURVEYED
C	C	CALCULATED

I HEREBY DECLARE THAT THE ABOVE PARCEL
WAS SURVEYED DURING MAY, 1992
PROPERTY LINES SHOWN ARE LOCATED FROM
DEEDS ON RECORD AND ARE DEED LINES.
BEARINGS ARE ASSUMED FOR ANGULAR MEA-
SUREMENT ONLY. ALL INFORMATION SHOWN IS
TRUE AND CORRECT TO THE BEST OF MY
KNOWLEDGE AND BELIEF.



James G. Homan, Jr. 5-23-92
JAMES G. HOMAN, JR., P.S. #6972 DATE
ORIGINAL SIGNED IN RED INK

HANK AND ASSOCIATES, INC.
ENGINEERING • SURVEYING
137 SOUTH WASHINGTON STREET, TIFFIN, OHIO 44883
419-447-4300

SURVEY FOR: JEFFREY MCCLAIN
LOCATED IN THE NE. 1/4 OF SECTION 15,
PITT TOWNSHIP, T-3-S, R-14-E,
WYANDOT COUNTY, OHIO

DRAWN BY:	CHECKED BY:	SHEET NO.
JUN 3-92	JUN 5-23-92	1 1
REVISIONS		JOB NO.
98008-S (14)		