


C.H. 103


## TOWNSHIP HIGHWAY 49 40' R/W

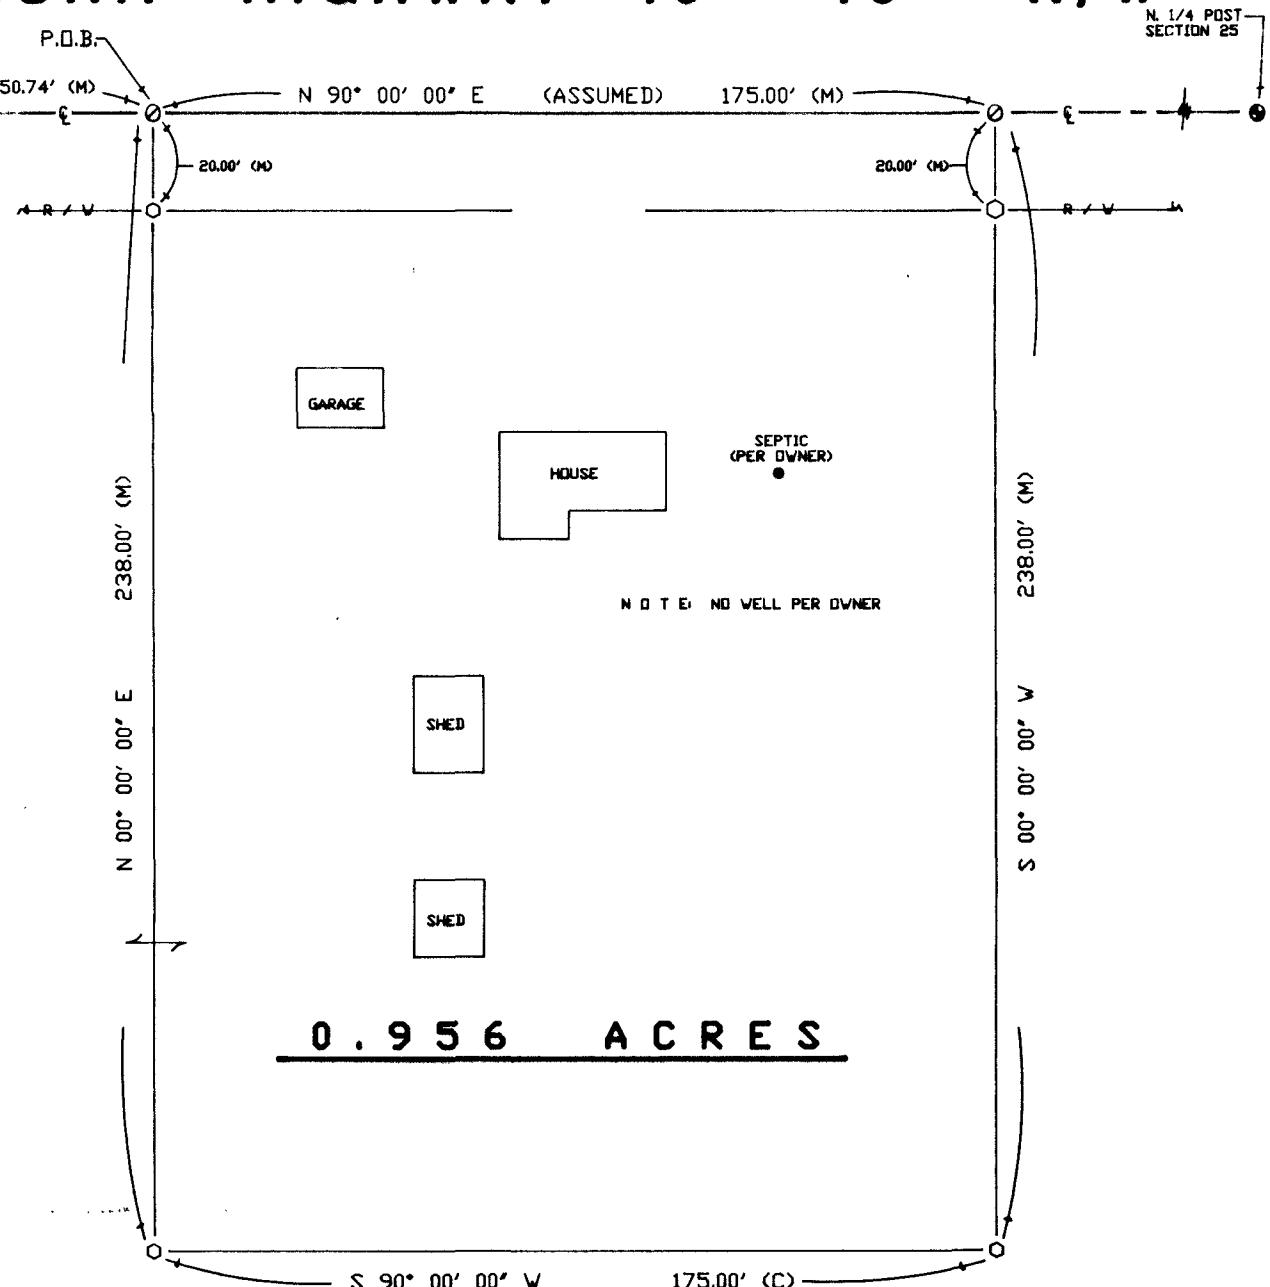

**HANK AND ASSOCIATES, INC.**  
 ENGINEERING • SURVEYING  
 137 SOUTH WASHINGTON STREET, TIFFIN, OHIO 44883  
 419-447-4300

**SURVEY FOR: ZELMA KERR**  
 LOCATED IN THE NW. 1/4 OF SECTION 25,  
 SALEM TOWNSHIP, T-2-S, R-13-E,  
 WYANDOT COUNTY, OHIO

61  
 1' = 40' 40 0 40  
 SCALE FEET

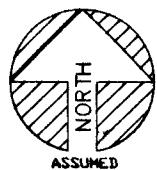

## REFERENCES

DEED VOLUME &amp; PAGE AS SHOWN

WYANDOT COUNTY CORNERSTONE REFERENCES

SURVEY NO. 9258VOL 8 PAGE 61DATE JULY 9, 1992

NOTE: ALL IRON ROD SET ARE 1/2" DIA. WITH  
 PERSONALIZED CAPS (HANK # 6972)  
 DRIVEN FLUSH.


## LEGEND

SET	FOUND	DESCRIPTION
△	▲	STONE
□	●	MONUMENT BOX
○	▲	CONC. MONUMENT
⊕	●	RAILROAD SPIKE
○	●	NAIL
○	○	IRON ROD
○	○	IRON PIPE
○	○	DRILL HOLE
○	○	WOOD POST
D	○	DEED
P	○	PLAT
M	—	MEASURED
S	—	SURVEYED
C	—	CALCULATED

I HEREBY DECLARE THAT THE ABOVE PARCEL

WAS SURVEYED DURING JUNE, 1992

PROPERTY LINES SHOWN ARE LOCATED FROM  
 DEEDS ON RECORD AND ARE DEED LINES.  
 BEARINGS ARE ASSUMED FOR ANGULAR MEA-  
 SUREMENT ONLY. ALL INFORMATION SHOWN IS  
 TRUE AND CORRECT TO THE BEST OF MY  
 KNOWLEDGE AND BELIEF.

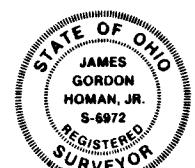

*SH*  
 JAMES G. HOMAN, JR., P.S. #6972 DATE  
 ORIGINAL SIGNED IN RED INK

DRAWN BY:	CHECKED BY:	SHEET NO.
DJN 6-92	JCH 6-30-92	1
REVISIONS		JOB NO.
		92070-S (489)