MIFFLIN
33 - 3 - 13
Vol. 6 Pg. 561

TAX MAP COPY

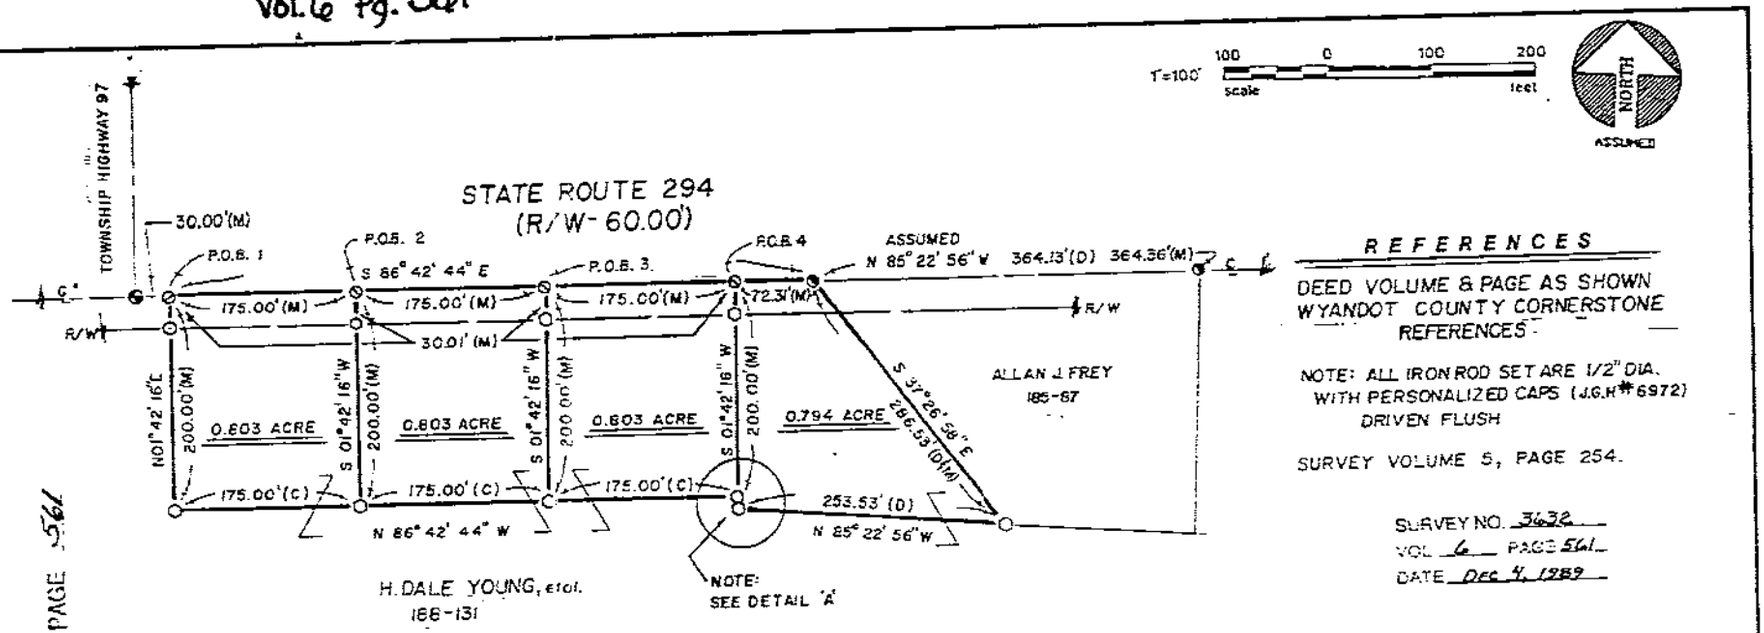

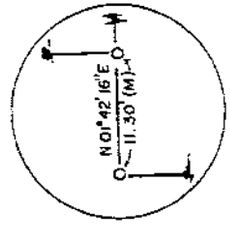

DETAIL 'A'

REFERENCES

DEED VOLUME & PAGE AS SHOWN
WYANDOT COUNTY CORNERSTONE
REFERENCES

NOTE: ALL IRON ROD SET ARE 1/2" DIA.
WITH PERSONALIZED CAPS (J.G.H #6972)
DRIVEN FLUSH

SURVEY VOLUME 5, PAGE 254.

SURVEY NO. 3632
VOL. 6 PAGE 561
DATE Dec 4, 1989

VOL. 6 PAGE 561

LEGEND

SET	FOUND	DESCRIPTION
△	▲	STONE
⊠	⊠	MONUMENT BOX
⊗	⊗	CONC MONUMENT
⊕	⊕	RAILROAD SPIKE
◑	◑	NAIL
⬢	⬢	IRON ROD
●	●	IRON PIPE
◆	◆	DRILL HOLE
■	■	WOOD POST
D		DEED
P		PLAT
M		MEASURED
S		SURVEYED
C		CALCULATED

I HEREBY DECLARE THAT THE ABOVE PARCEL WAS SURVEYED DURING Nov 1989. PROPERTY LINES SHOWN ARE LOCATED FROM DEEDS ON RECORD AND ARE DEED LINES. BEARINGS ARE ASSUMED FOR ANGULAR MEASUREMENT ONLY. ALL INFORMATION SHOWN IS TRUE AND CORRECT TO THE BEST OF MY KNOWLEDGE AND BELIEF.

STATE OF OHIO JAMES G. HOMAN JR. 6972 REGISTERED SURVEYOR

James G. Homan Jr. 11-26-89
JAMES G. HOMAN, JR., P.S. #6972 DATE
ORIGINAL SIGNED IN RED INK

HANK AND ASSOCIATES, INC.
ENGINEERING • • SURVEYING
49 SOUTH WASHINGTON STREET, TIFFIN, OHIO 44883
419-447-4300

SURVEY FOR: H. DALE YOUNG
LOCATED IN THE W1/2 OF SECTION 33, MIFFLIN TOWNSHIP,
T-3-S, R-13-E, WYANDOT COUNTY, OHIO

DRAWN BY:	CHECKED BY:	SHEET NO
frs 11-21-89		1 / 1
REVISIONS		JOB NO
		89111 - S